


MAP OF PROPERTY

SURVEYED FOR
LOCATED AT *East Hampton* SUFFOLK COUNTY, N. Y.

LOT
MAP OF *N/A*
FILED
MAP NO.
SCALE 100 FEET TO 1 INCH
• = STAKE O = IRON PIPE
■ = MONUMENT ▲ = SPIKE
TAX MAP NO. 300-133-1-30.4

ELEVATIONS REFER TO AN ASSUMED DATUM
Lot Area: 191,948 S.F. = 4.406 AC.

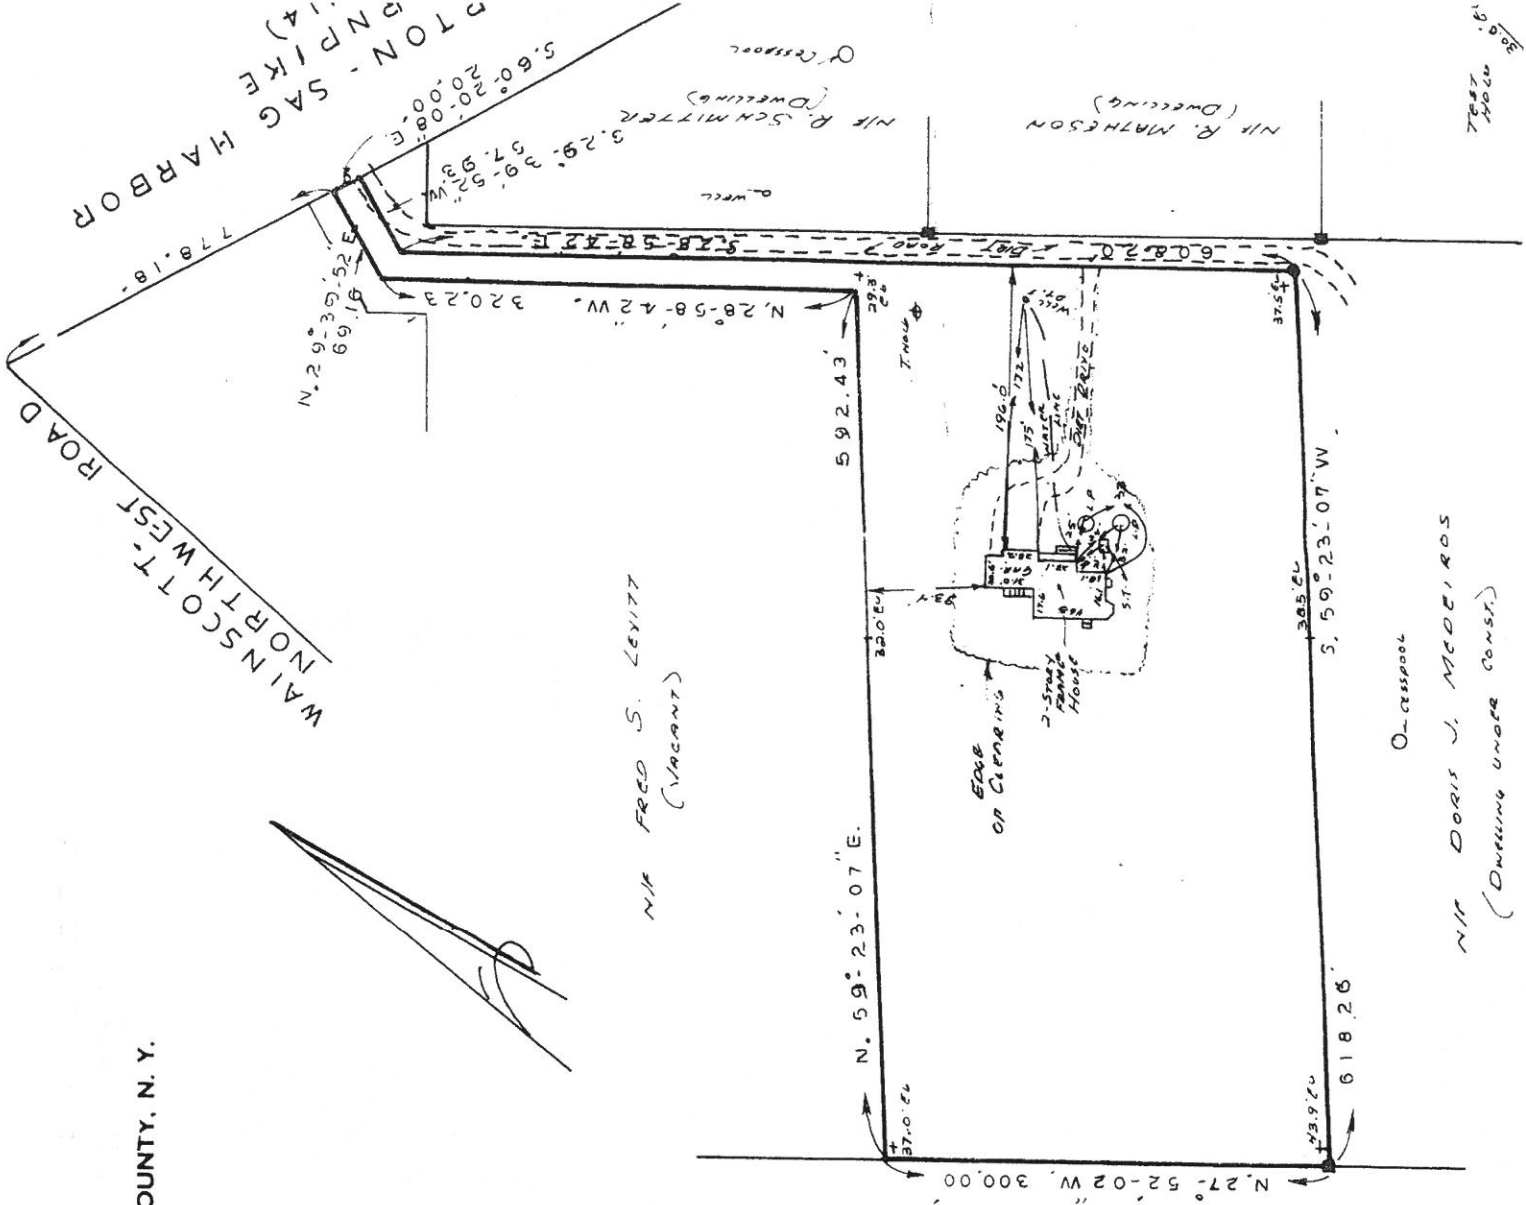

Area Clearing - 20,800 S.F.
∴ Lot Clearing - 10.00%

