


A-7219

TITLE No. 1231527

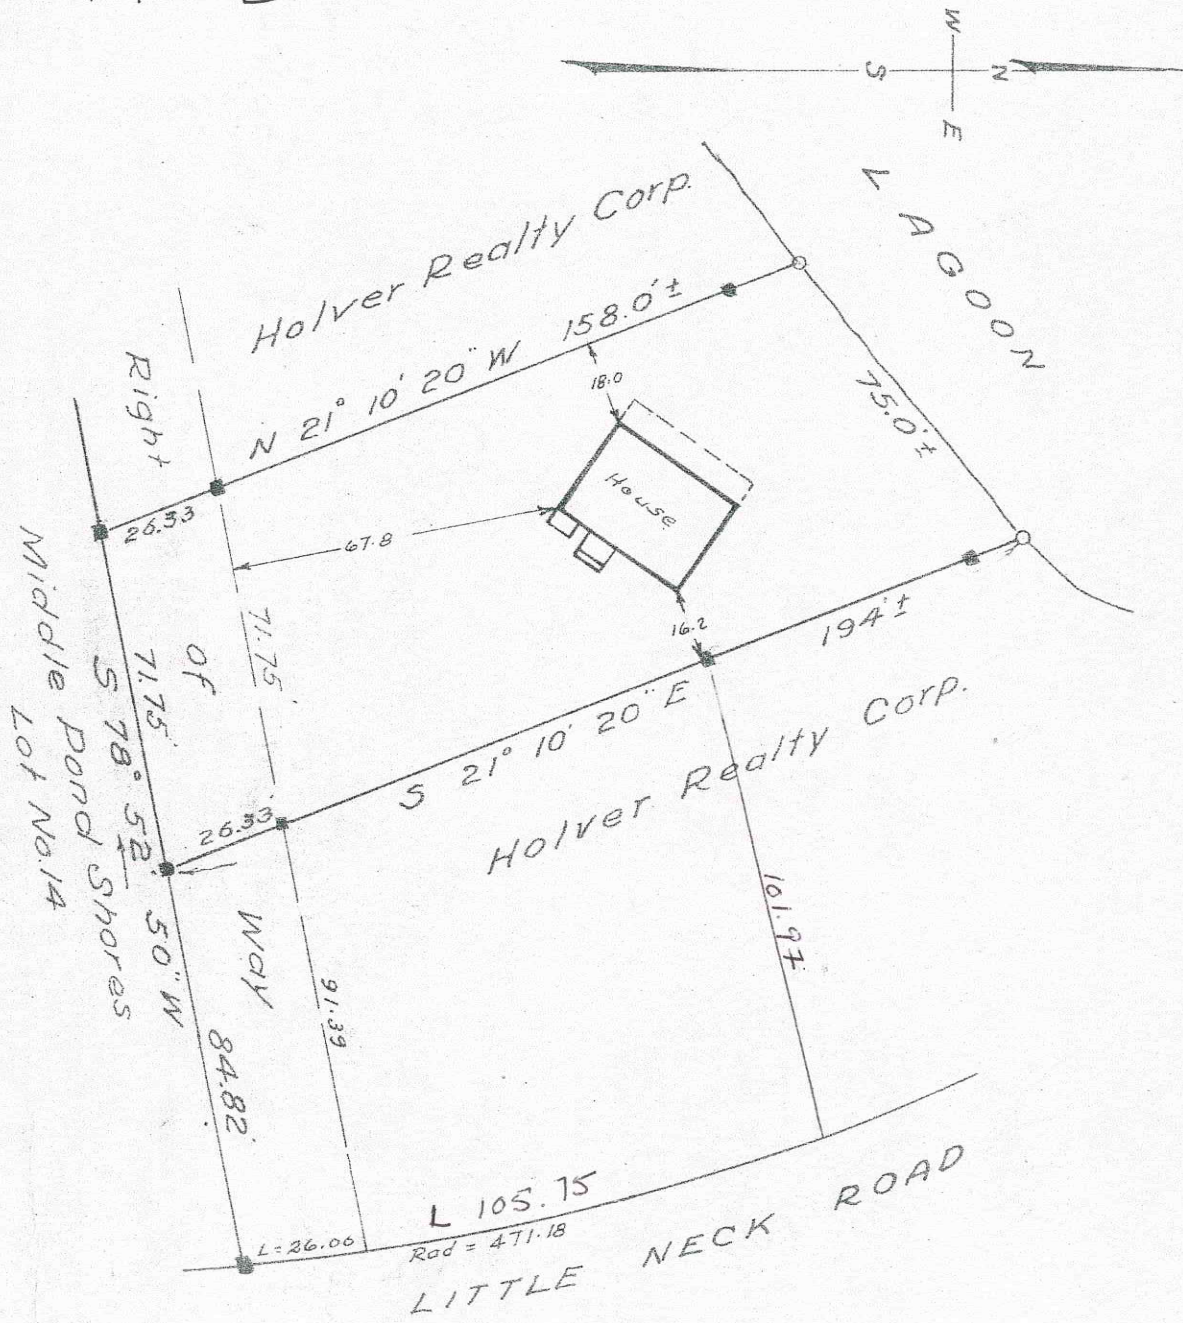

Imperiale, F 28726
89 Little Neck Rd
Southampton
(+871/2)

MAD OF PROPERTY
OWNED BY
SONIA & MAURICE SCHOTLAND
SITUATE
SHINNECOCK HILLS
TOWN OF SOUTHAMPTON NY

Guaranteed to:
Southampton Federal Savings & Loan Assoc.
The Title Guarantee Company
Surveyed Oct 31, 1956 Re-surveyed October 5, 1960
Theodore F. Squires
Hudson F. Squires
Licensed Land Surveyor No. 15683
Southampton, NY

SCALE 1"=40'