



DISTRICT 0904  
SECTION 008.00  
BLOCK 02.00  
PARCEL 009.000

■ INDICATES MONUMENT

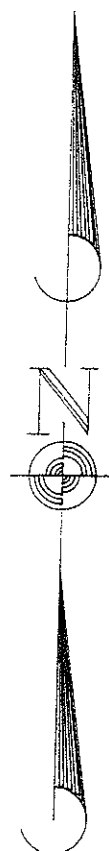

ELM STREET

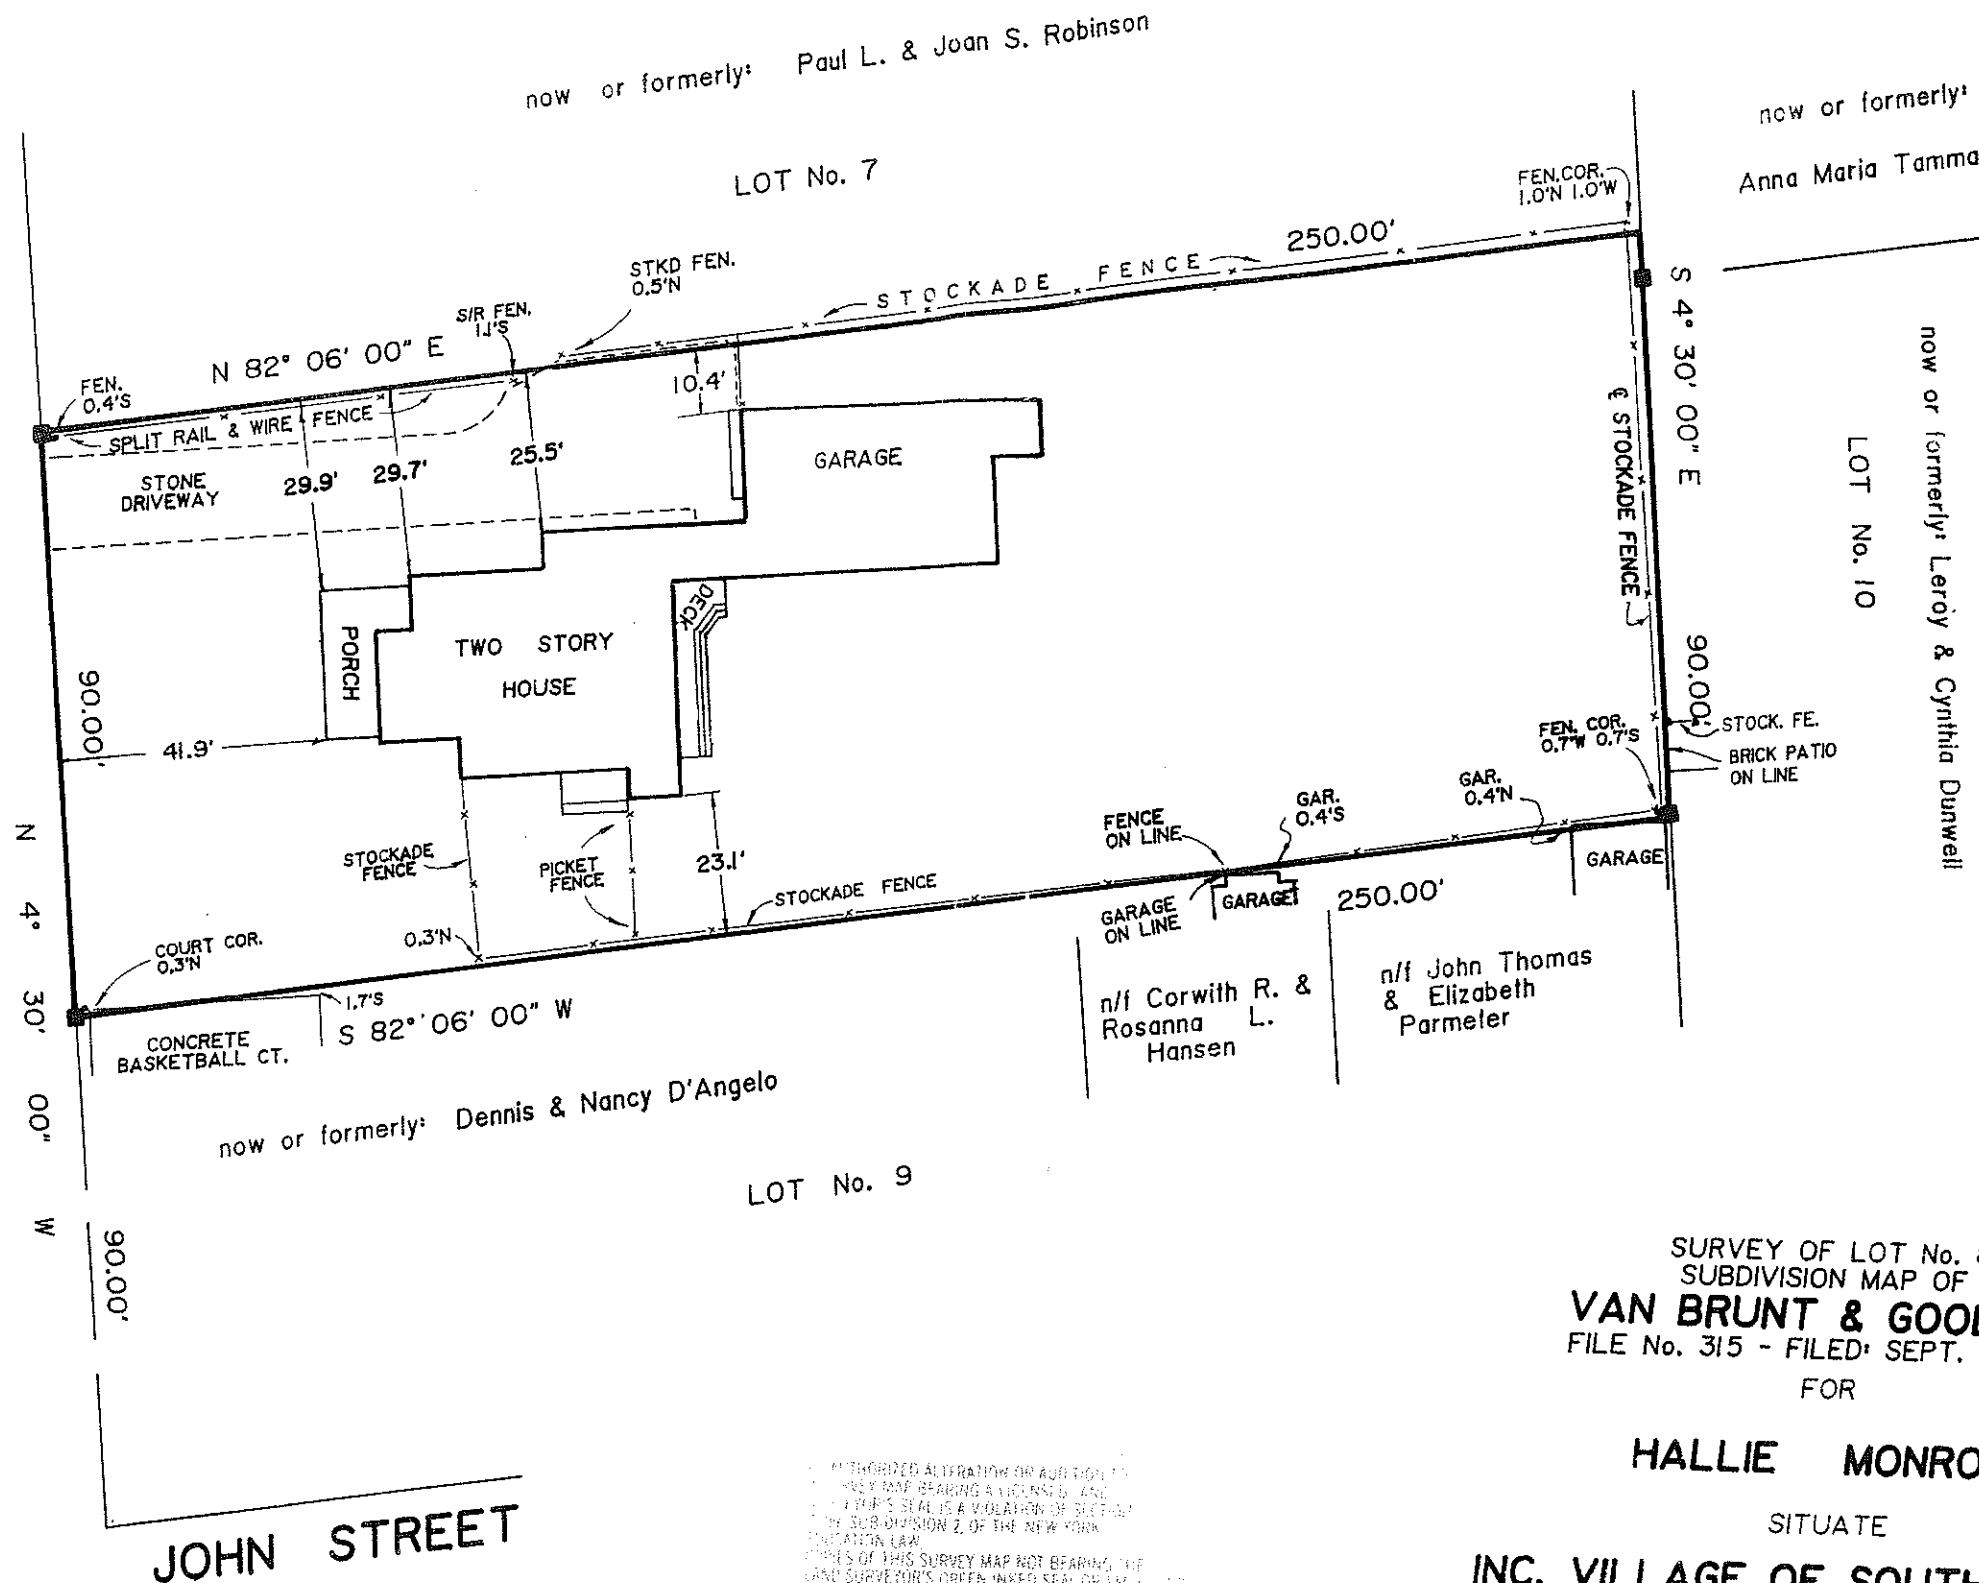

SURVEY OF LOT No. 8  
SUBDIVISION MAP OF  
**VAN BRUNT & GOODALE**  
FILE No. 315 - FILED: SEPT. 4, 1901  
FOR

**HALLIE MONROE**  
SITUATE  
**INC. VILLAGE OF SOUTHAMPTON**

TOWN OF SOUTHAMPTON  
SUFFOLK COUNTY, N.Y.

SCALE: 1" = 30'

AREA = 22,460 SQ. FT. (0.516 AC.)

REVISED: NOV. 12, 2001 (Update)  
REVISED: MAY 1, 1995 (Locate Fences)  
REVISED: JAN. 20, 1995 (Locate Addition)  
SURVEYED: AUG. 25, 1993

*Lester Holden*

LESTER HOLDEN, L.S. No. 49548  
S. H. W. & S., LAND SURVEYORS, P.C.  
**SQUIRES, HOLDEN, WEISENBACHER & SMITH**  
LAND SURVEYORS ~ ENGINEERS

SOUTHAMPTON ~ NEW YORK

NOT A TRUE COPY  
THIS SURVEY MAP BEARING A LICENSED LAND SURVEYOR'S SEAL IS A VIOLATION OF SECTION 2 OF THE SUB-DIVISION 2 OF THE NEW YORK EDUCATION LAW  
COPIES OF THIS SURVEY MAP NOT BEARING THE LAND SURVEYOR'S GREEN INKED SEAL OR THE SEAL OF THE SUB-DIVISION 2 OF THE NEW YORK EDUCATION LAW SHALL NOT BE CONSIDERED TO BE A TRUE COPY  
CERTIFICATIONS INDICATED HEREON SIGNIFY THAT THIS SURVEY WAS PREPARED IN ACCORDANCE WITH THE EXISTING CODE OF PRACTICE FOR LAND SURVEYING BY THE NEW YORK STATE ASSOCIATION OF PROFESSIONAL LAND SURVEYORS, S.A.P.L.S., AND SHALL BE PREPARED AND ON HIS BEHALF BY THE LAND SURVEYOR, HALLIE MONROE, INC., AND NOT BY ANY OTHER PERSON, FIRM, GOVERNMENTAL AGENCY, OR INSTITUTION, IDENTIFICATIONS ARE NOT SUBJECT TO ADDITIONAL INSTITUTIONS OR OWNERS