

FINAL

FOR SUPPLY & WASTE DISPOSAL
FOR THIS RESIDENCE WILL
TO THE STANDARDS OF
FOLK COUNTY DEPARTMENT
WITH SERVICES.

APPLICANT

LOT 249

DREDGED
BASIN

40.13

N32°44'00"W
25.00

N57°16'00"E

EL 5.2 EL 5.5 EL 6.2 EL 5.8 EL 5.5


P/O LOT 250

N57°16'00"E

170.00

FD. MON.
EL. 5.5

P/O LOT 250

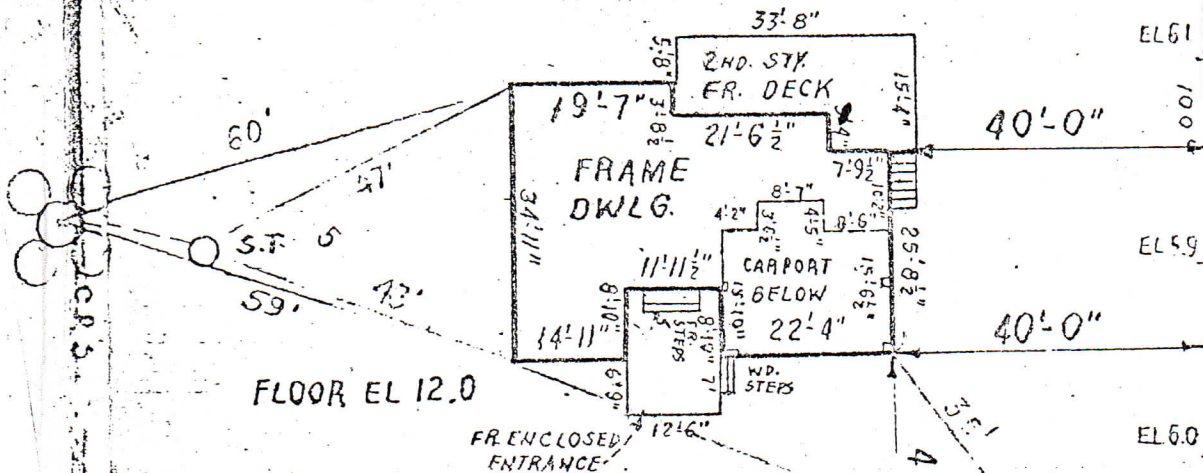

S32°44'00"E

125.00

APPROVED

LOT 251

F.P.W. 02"
ON UNIFORM
Set Mon

S57°16'00"W

191.41

EDGE OF PAVEMENT

(31' WIDE OIL & STONE PAVEMENT)

EL 5.2 EL 5.9 EL 6.24 EL 6.20 EL 6.24 EL 6.51 EL 6.91 EL 7.27

KINGS POINT ROAD

EDGE OF PAVEMENT
POLE (66' WIDE)

13'