
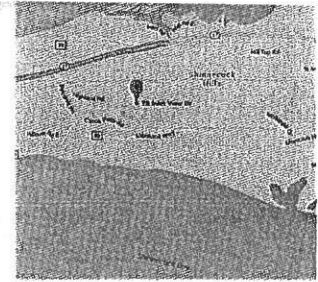



Volume 7

# INLET VIEW DRIVE

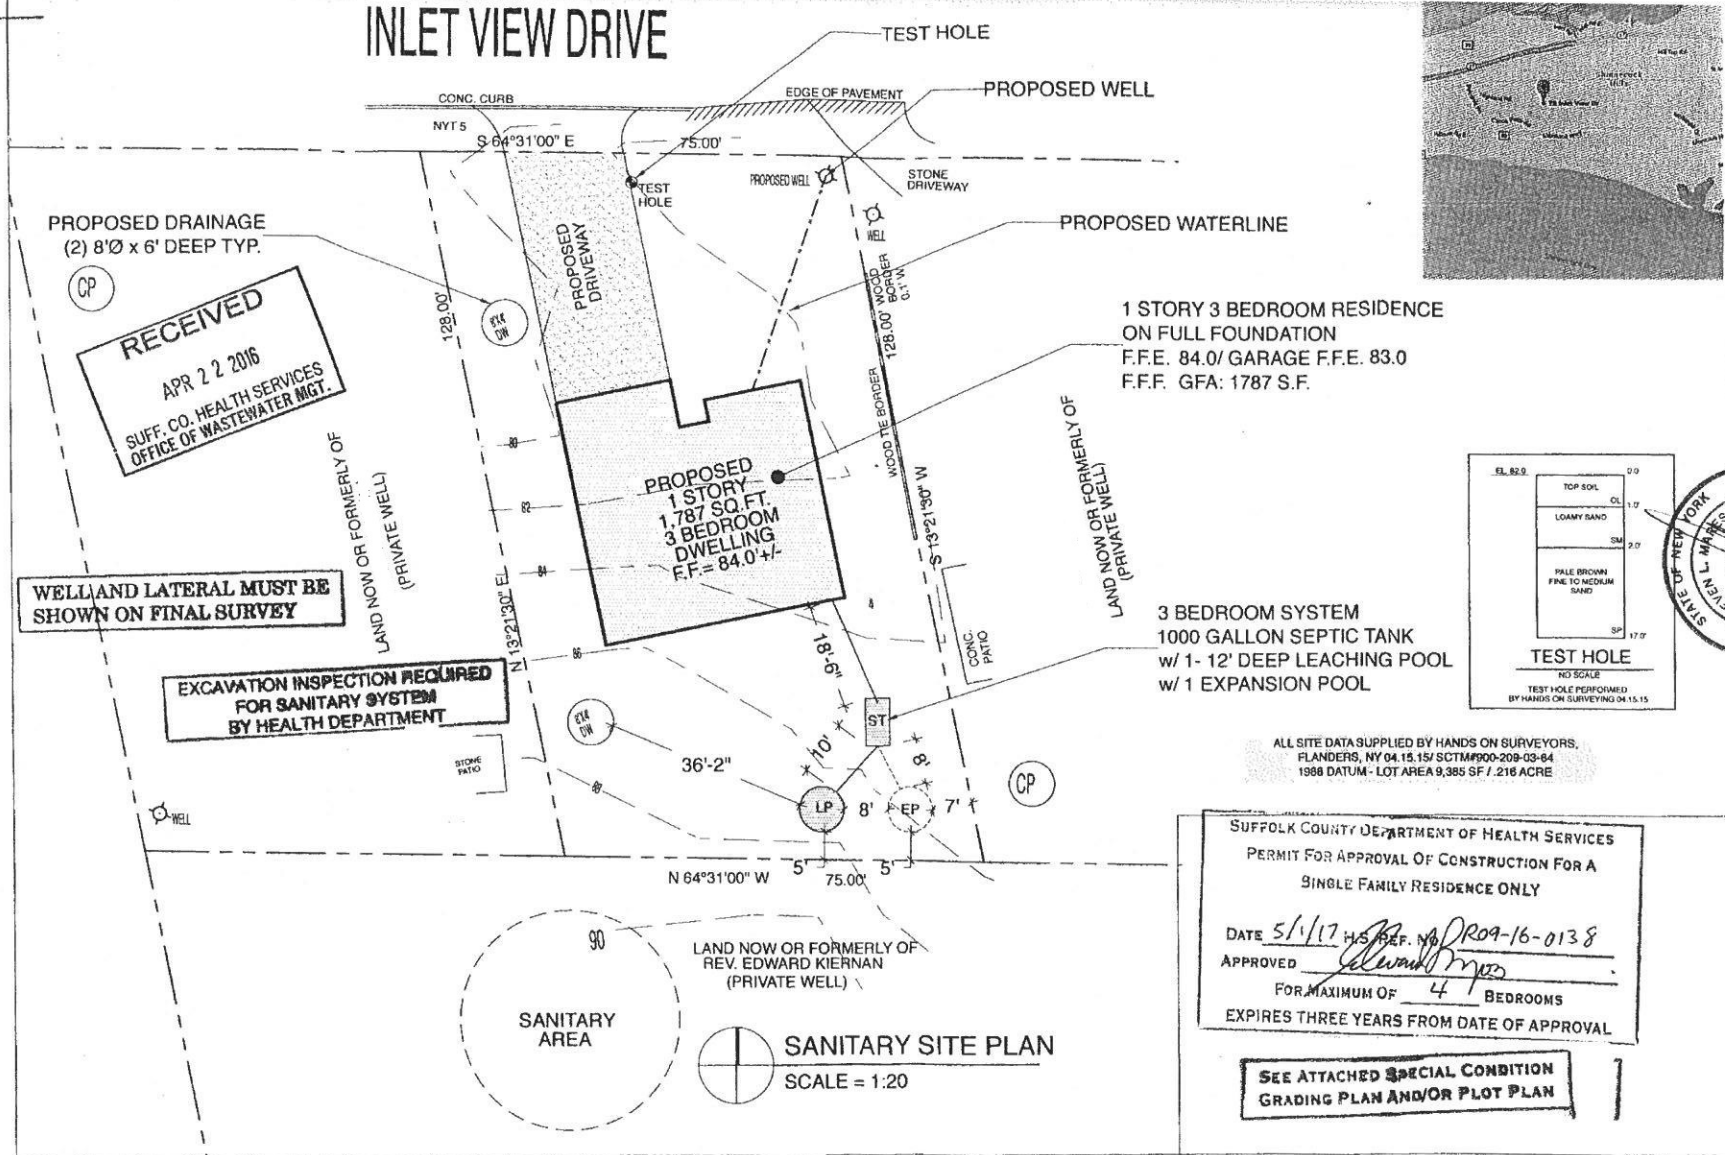

NO.	REVISIONS	DATE

CONSULTING ENGINEER  
8-07 WEST MONTAUK HIGHWAY  
HAMPTON BAYS, NY 11946

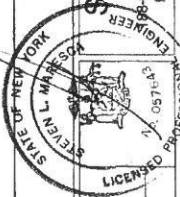

20 INLET VIEW DRIVE  
SOUTHAMPTON, NY

**SANITARY SITE PLAN**

DRAWN: KJM  
DATE: 01.29.16  
SCALE: AS NOTED  
SHEET

**SAN-1**  
OF 2 SHEETS