


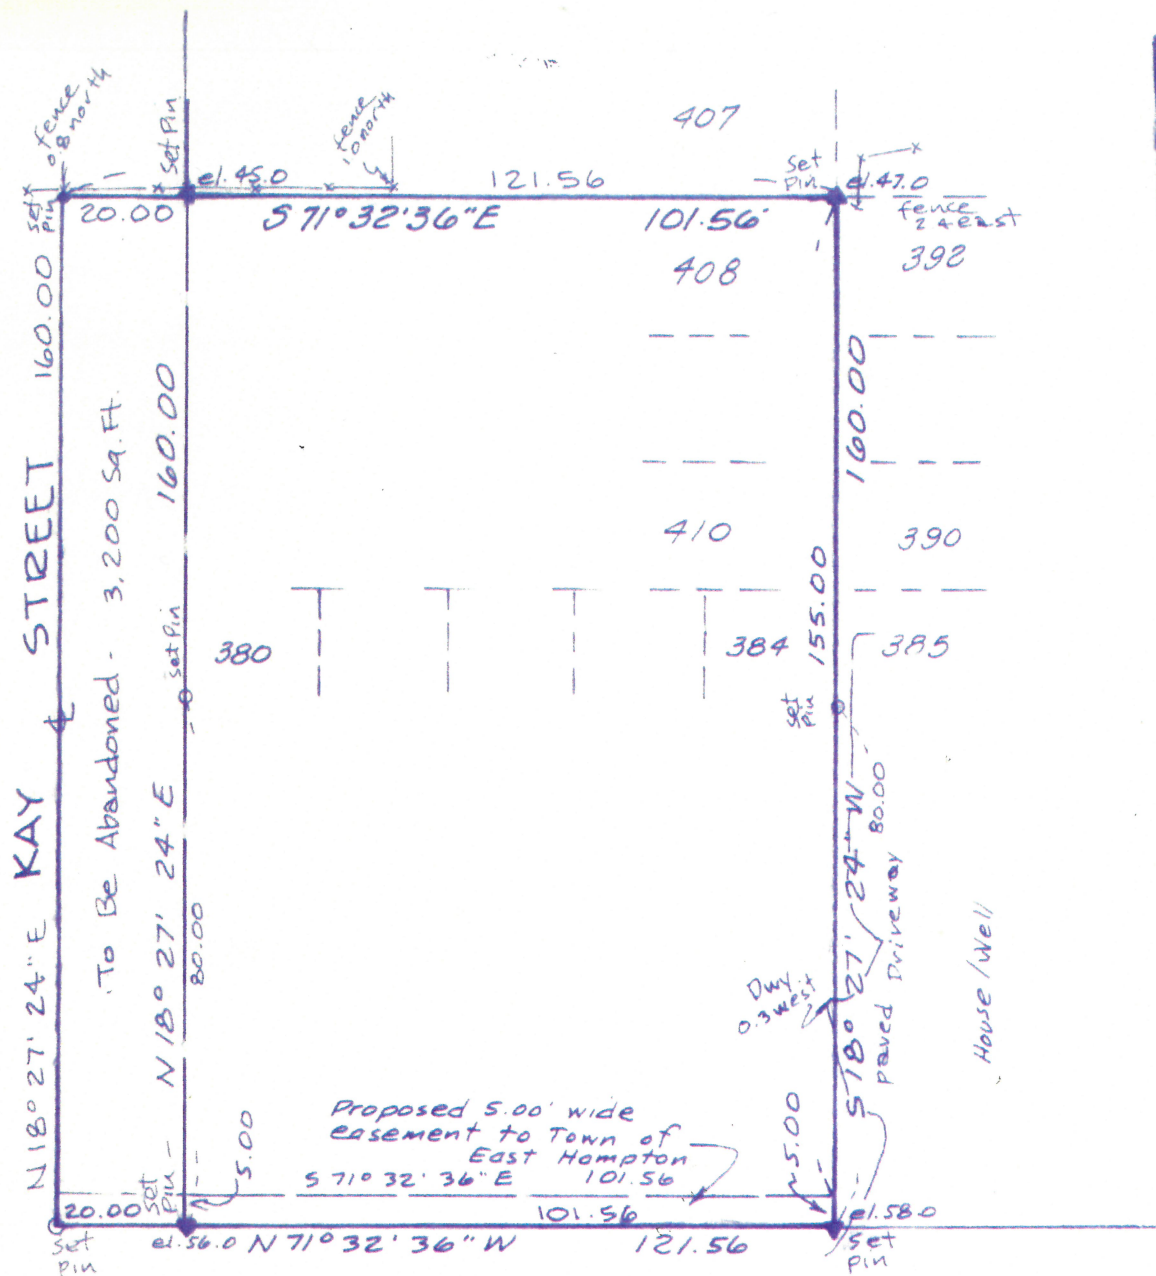

D 10343

970-76

Lots 380-384 incl. &
Lots 408-410 incl.
Block 15

Olympic Heights Exten.
Section Three

Filed: Apr. 15, 1913 - Map No. 171

Town of East Hampton - Suffolk County - N.Y.

Total Area (incl. Pl. Kay St.) - 19,450 Sq. Ft.

Scale: 1" = 30'

.446 ACRES

Certified to:
Chicago Title Insurance Company

Notes:
1) Any unauthorized alteration or addition to a survey map bearing a licensed surveyor's seal is a violation of section 17-102 of the New York State Education Law.
2) Only copies from the original of this survey map bearing an original land surveyor's embossed seal shall be considered to be a valid copy.
3) Certifications indicated hereon shall run only to the person for whom the survey was prepared, and on his/her behalf to the title company, governmental agency and lending institution listed hereon. Certifications are not transferable to additional institutions or subsequent owners. Certifications indicated hereon signify that this survey was prepared in accordance with the existing code of practice for land surveyors adopted by the New York State Association of Professional Land Surveyors.
4) The existence of subsurface improvements or encroachments, or wetlands, or easements, covenants, or restrictions of record, if any, not shown are not certified.

Resurveyed: October 15, 2002
Revised: June 28, 1985 - EASE.
Revised: October 24, 1984 - Set Stakes
Surveyed: October 11, 1984

GEORGE WALBRIDGE SURVEYORS, P.C.
Land Surveyors & Land Planners
East Hampton - Long Island - N.Y.

Crystal Drive
open/paved

U.R. Parcel 18 - Sheet E.H. 3
T.M. 0300-120-04-13.4

Handwritten signature: G. Walbridge