

86 EH 363

D3939 A


537-155 143

NOTE: The existence of right of ways, wetlands and/or easements of record, if any, not shown are not guaranteed

Test Hole Data:

0.0 - 1.0' Top soil
1.0' - 8.0' Sandy loam
8.0 - 18.0' Sand, gravel

Fourth St.
(Not Open)

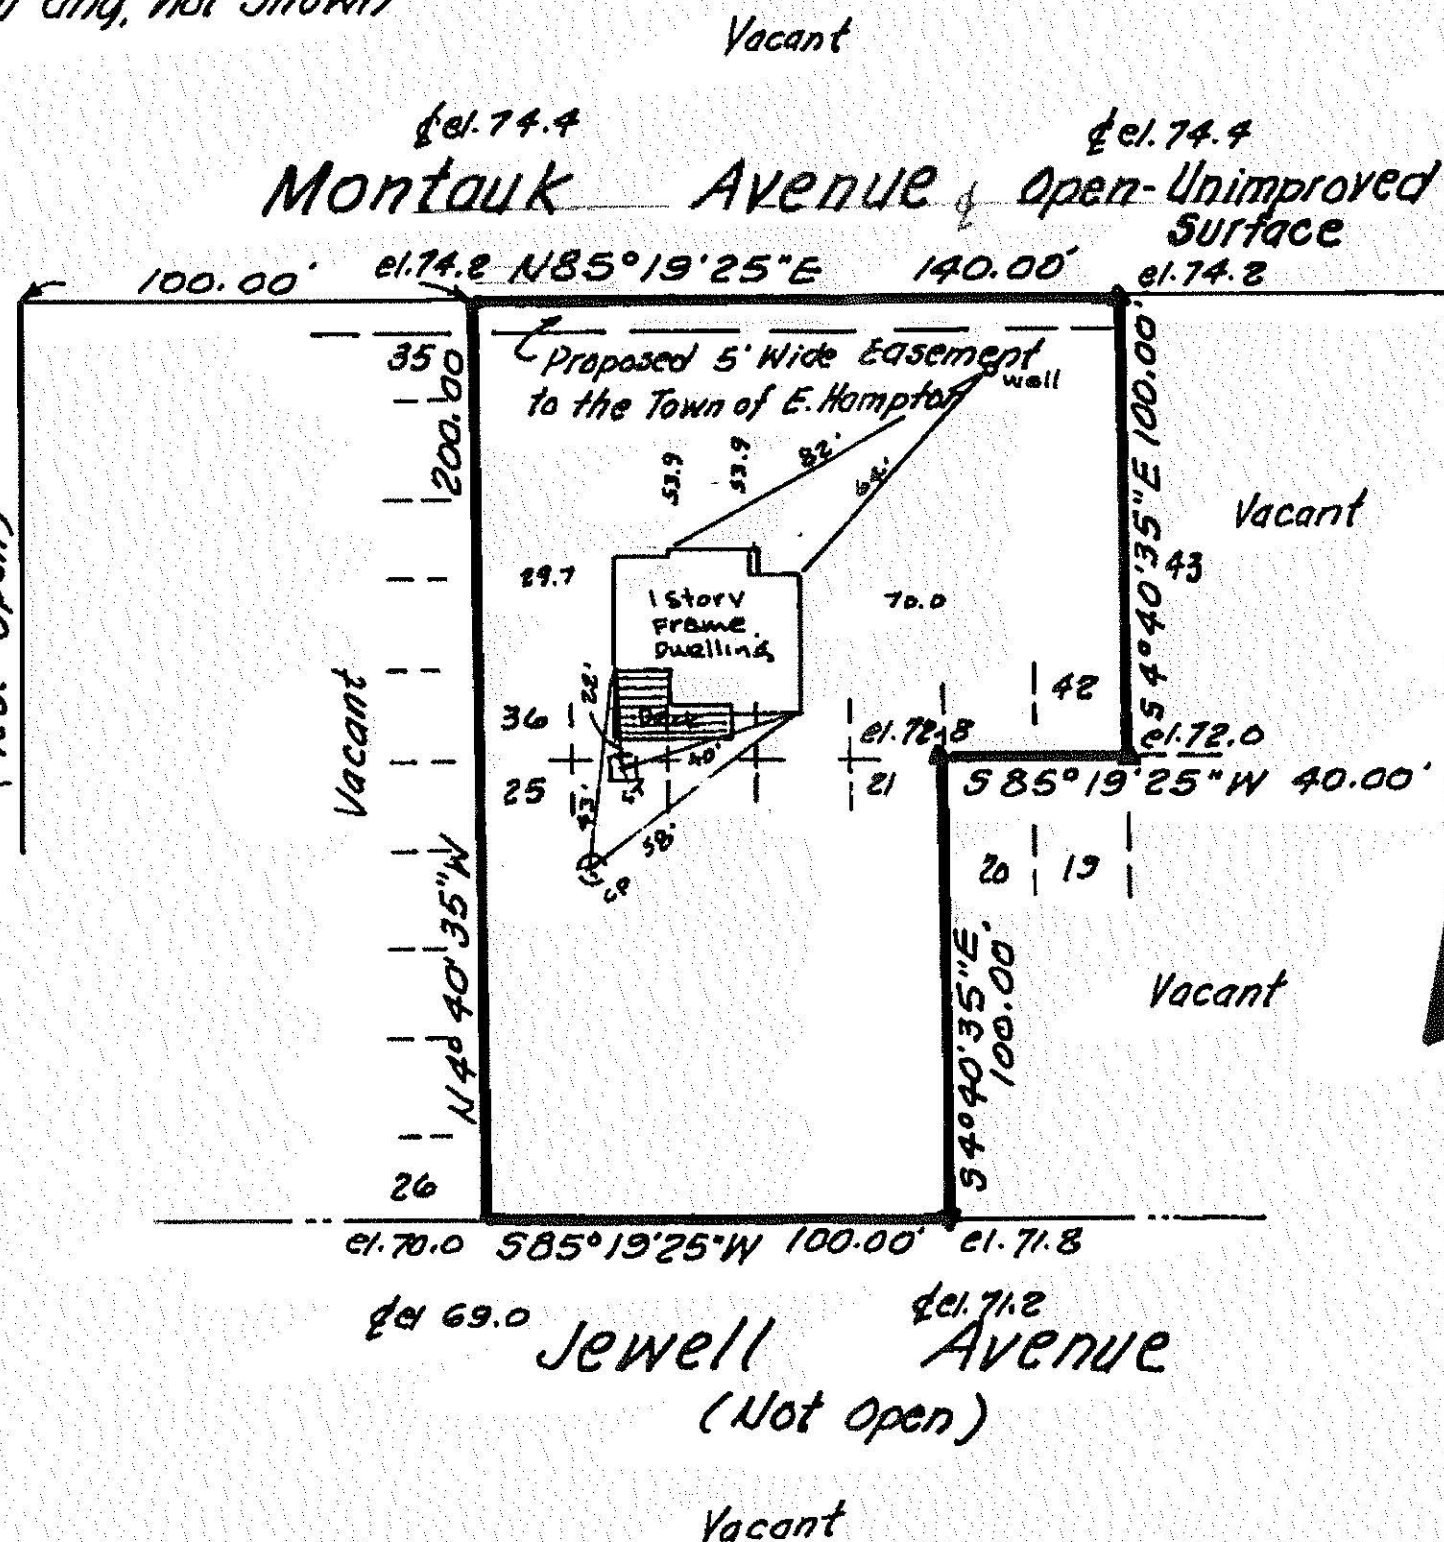

Lots 21-25 & 36-42
Block 8
Map of
Montauk Manor No. 3
Filed Apr. 19, 1911 - Map 265
Town of East Hampton - Suffolk Co.
New York
Scale: 1" = 50'

UNAUTHORIZED ALTERATION OR ADDITION TO THIS SURVEY IS A VIOLATION OF SECTION 1204 OF THE NEW YORK STATE EDUCATION LAW.

COPIES OF THIS SURVEY MAP NOT BEARING THE SAME SURVEYOR'S INKED SEAL OR PROCEDED SEAL SHALL NOT BE CONSIDERED TO BE A VALID TRUE COPY.

GUARANTEES INDICATED HEREON SHALL RUN ONLY TO THE PERSON FOR WHOM THE SURVEY IS PREPARED, AND ON HIS BEHALF TO THE TITLE COMPANY, GOVERNMENTAL AGENCY AND LENDING INSTITUTION LISTED HEREON, AND TO THE ASSIGNEES OF THE LENDING INSTITUTION. GUARANTEES ARE NOT TRANSFERABLE TO ADDITIONAL INSTITUTIONS OR SUBSEQUENT OWNERS.

GEORGE H. WALBRIDGE, JR.

[Signature]