

N/O/F HEAD OF THE POND, INC.
N. 42°13'50" E. 170.00'

LOT

LOT 11
N. 47°46'10" W.

LOT 10

S. 31°00'00" E.



WINDING (GARRETT LANE) WAY

FLYING GOOSE PATH
(GARRETT COURT)



SUFFOLK COUNTY DEPARTMENT OF HEALTH SERVICES

SINGLE FAMILY DWELLING ONLY

DATE: AUG 06 1993 S. REF. NO. 93-SH-48

The sewage disposal and water supply facilities for this location have been inspected by this Department and/or other agencies and found to be satisfactory.

Stephen A. Costa, PE

Chief of Bureau of Wastewater Management

SURVEY OF

LOT 10

"GARRETT ASSOCIATES"
FILED DECEMBER 14, 1983 FILE NO. 7868

AT WATER MILL
TOWN OF SOUTHAMPTON
SUFFOLK COUNTY, N.Y.

900 - 113 - 03 - 8.15

Scale: 1" = 40'

Feb. 10, 1993

July 30, 1993 (final)



NO. 49618

PECONIC SURVEYORS
(516) 765-1588
P. O. BOX 809
MAIN ROAD

RECEIVED

AUG 5 1993


S.C. DEPT. OF
HEALTH SERVICES

Prepared in accordance with the minimum standards for title surveys as established by the L.I.A.L.S. and approved and adopted for such use by The New York State Land Title Association.

CERTIFIED TO:
LYNCH HOMES, INC.
TICOR TITLE GUARANTEE CO.

AREA= 28.576 sa.ft.

Q 15432

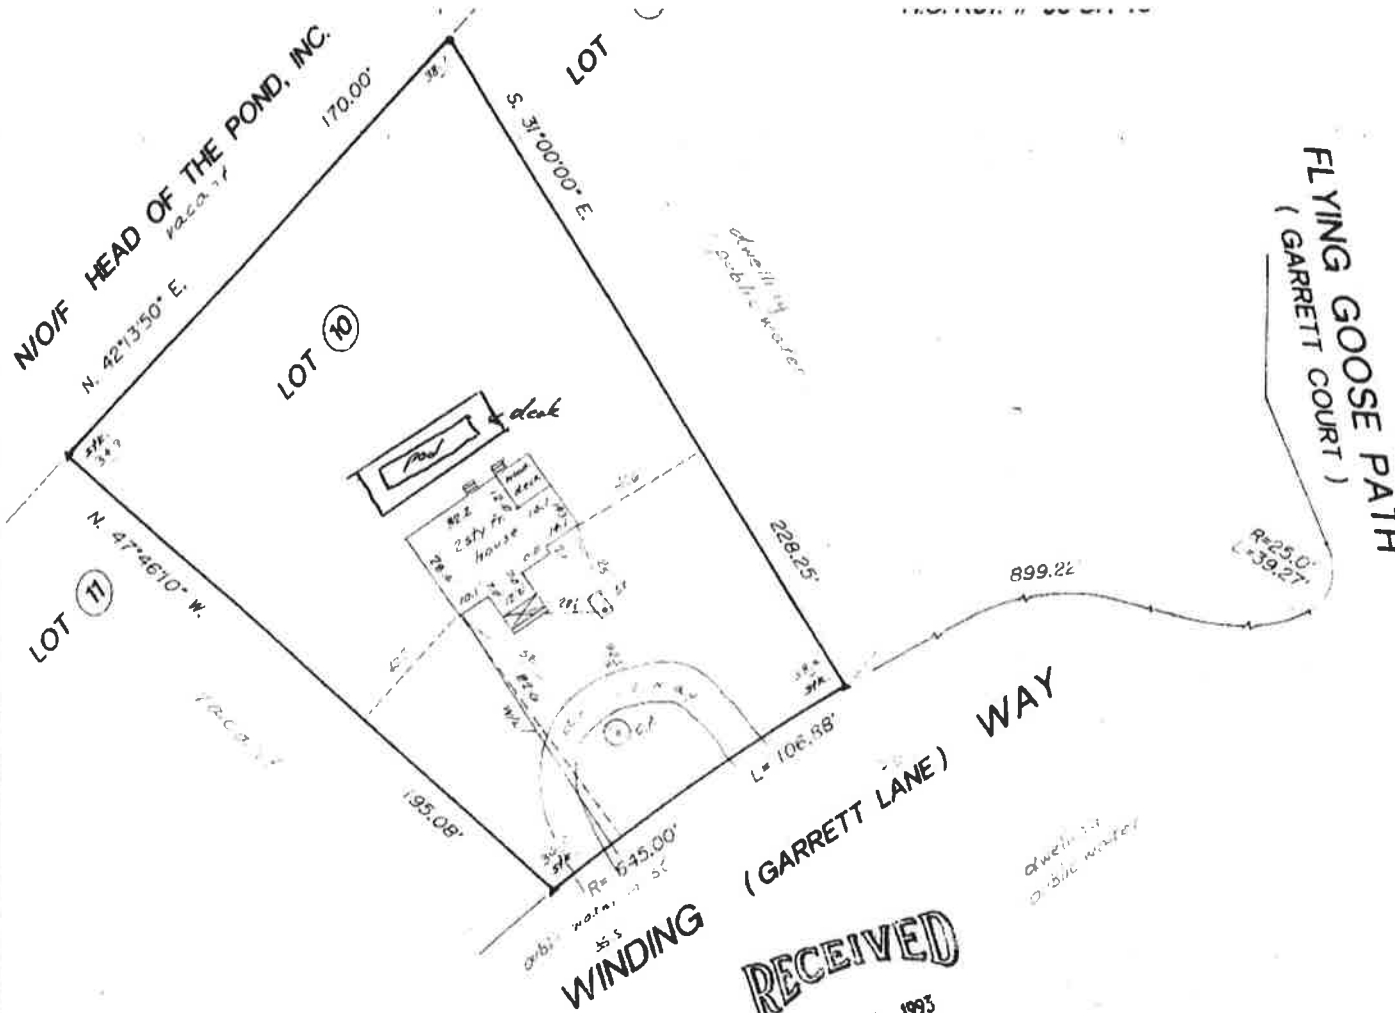

SUFFOLK COUNTY DEPARTMENT OF HEALTH SERVICES
 SINGLE FAMILY DWELLING ONLY
 DATE: AUG 06 1993 S. REF. NO. 93-SH-48
 The sewage disposal and water supply facilities for this location have been inspected by this Department and/or other agencies and found to be satisfactory.
Stephen A. Costa, PE
 Chief of Bureau of Wastewater Management

**SURVEY OF
 LOT 10
 "GARRETT ASSOCIATES"
 FILED DECEMBER 14, 1983 FILE NO. 7068
 AT WATER MILL
 TOWN OF SOUTHAMPTON
 SUFFOLK COUNTY, N.Y.
 900 - 113 - 03 - 8.15
 Scale: 1" = 40'
 Feb. 10, 1993
 July 30, 1993 (final)**

RECEIVED
 AUG 5 1993
 S.C. DEPT. OF
 HEALTH SERVICES

CERTIFIED TO:
 LYNCH HOMES, INC.
 TICOR TITLE GUARANTEE CO.

Prepared in accordance with the minimum standards for title surveys as established by the L.I.A.L.S. and approved and adopted for such use by The New York State Land Title Association.

AREA= 28.576 sq.ft.

Q 15432

STATE OF NEW YORK
 JOHN T. METZGER
 LAND SURVEYOR
 NO. 49618
 PECONIC, N.Y.
 (516) 765-1568
 P. O. BOX 809
 MAIN ROAD