



Subdivision Map-"Montauk Gardens"
Suff Co. File No. 483

Subdivision Map-
"Montauk Gardens, Sect. 1"
Suff Co. File No. 655

Survey for:

Lots 97-104, 107, p/o Lots 105-106,
p/o Clarendon Street & p/o Ray Place
"Montauk Heights, Section 1"

Town of
East Hampton
Suffolk County, New York

S.C.T.M.: 0300-136.00-09.00-018.003


NOTES:

1. TOTAL AREA = 28,639 S.F.
AREA EXCLUDING FLAG = 26,839 S.F.
2. ■ = MONUMENT FOUND, ▲ = STAKE FOUND,
● = SPIKE FOUND, △ = STAKE SET.
3. SUBDIVISION MAP FILED IN THE OFFICE OF THE CLERK
OF SUFFOLK COUNTY ON JUNE 21, 1911 AS FILE NO. 483.
4. ALLOWABLE CLEARING = 10,000 S.F.
EXISTING CLEARING = 15,785 S.F.

APR. 26, 2004 INDICATED CLEARING
MAR. 12, 2004 AMENDED FENCE
DEC. 05, 2003 FINAL SURVEY
MAR. 27, 2002 STAKE SET BACK
JUN. 23, 2001 STAKE SET HOUSE
APR. 25, 2001 INDICATED CLEARING LINE
MAR. 21, 2001 15% POOL FOR CONSTRUCTION

DATE: JAN. 08, 2001
SCALE: 1"=30'
JOB NO: 2000-294

now or formerly
Aileen M. Gaffney

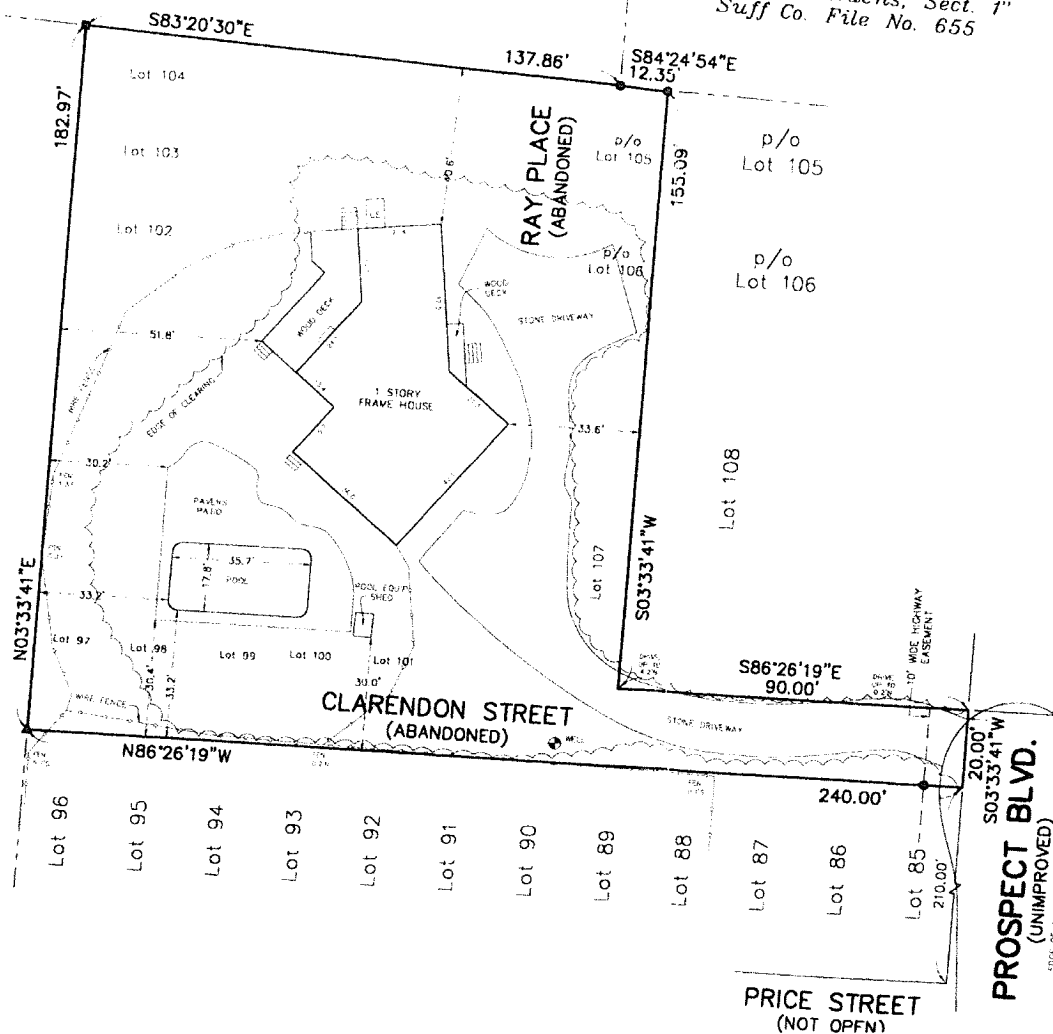

DAVID H. FOX N.Y.S.L.S. #50234
FOX LAND SURVEYING
PO BOX 224
SPEONK, N.Y. 11972
(631) 325-2902

UNAUTHORIZED ALTERATION OR ADDITION TO THIS SURVEY
IS A VIOLATION OF SECTION 2205 OF THE NEW YORK STATE
EDUCATION LAW. COPIES OF THIS SURVEY MAP NOT BEARING
THE LAND SURVEYOR'S NAME, SEAL OR EXPIRED SEAL
SHALL NOT BE CONSIDERED TO BE A VALID TRUE COPY.
REPRODUCTION INDICATED HEREON SHALL RUN ONLY TO THE
PERSON FOR WHOM THE SURVEY IS ORDERED AND TO THE
RECORDS OF THE TITLE COMPANY, GOVERNMENTAL AGENCY
AND LENDING INSTITUTION LISTED HEREON. AND TO THE
ASSIGNMENT OF THE LAND AND INSTITUTION CERTIFICATIONS
ARE NOT TRANSFERABLE TO ADDITIONAL COPIES OR
SUBSEQUENT OWNERS.

OWG: 2000-294