


Minor Subdivision of Property
Of Douglas Carlton & Gloria Strong
Lot 1

Survey for:
BARNETT CONSTRUCTION CORPORATION
Lot 14, "Sagaponack Close"
At
Sagaponack
Town of
Southampton
Suffolk County, New York

S.C.T.M.: 0908-007.00-02.00-020.000

NOTES:

1. AREA = 40,206 S.F.
2. ▲ = STAKE FOUND.
3. SUBDIVISION MAP "SAGAPONACK CLOSE" FILED IN THE OFFICE OF THE CLERK OF SUFFOLK COUNTY ON MAR. 27, 1984 AS FILE NO. 7721.

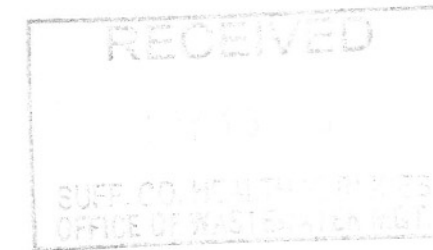

MAY 12, 2009 AMENDED SANIT MEAS.
MAY 05, 2009 UPDATE FINAL SURVEY
APR. 01, 2009 FINAL SURVEY
JAN. 23, 2008 STK. FOR CONSTRUCTION
NOV. 30, 2007 AMENDED PROP. HOUSE

DATE: AUG. 17, 2001
SCALE: 1"=40'
JOB NO: 2001-325

CERTIFIED TO:
BARNETT CONSTRUCTION CORP.

[Signature]

DAVID H. FOX N.Y.S.L.S. #50234
FOX LAND SURVEYING
64 SUNSET AVENUE
WESTHAMPTON BEACH, NY 11978
(631) 288-0022

UNAUTHORIZED ALTERATION OR ADDITION TO THIS SURVEY IS A VIOLATION OF SECTION 2209 OF THE NEW YORK STATE EDUCATION LAW. COPIES OF THIS SURVEY MAY NOT BEARING THE LAND SURVEYOR'S NAME, SEAL OR EMPRESSED SEAL, SHALL NOT BE CONSIDERED TO BE A VALID TRUE COPY.

CERTIFICATION INDICATED HEREIN SHALL RUN ONLY TO THE PERSON FOR WHOM THE SURVEY IS PREPARED AND ON HIS BEHALF TO THE TITLE COMPANY, GOVERNMENTAL AGENCY AND LENDING INSTITUTION LISTED HEREON, AND TO THE ASSIGNEES OF THE LENDING INSTITUTION. CERTIFICATIONS ARE NOT TRANSFERABLE TO ADDITIONAL INSTITUTIONS OR SUCCESSFUL OWNERS.

SUFFOLK COUNTY DEPARTMENT OF HEALTH SERVICES
APPROVED FOR CONSTRUCTION WORKS FOR
Date **MAY 20 2009** *R09-07-047*
The next to appear in the County of Suffolk and into the public have been
inspected and found to be satisfactory for a **7** BEDROOMS.
[Signature]
Walker J. Hilbert, P.E., Chief
Office of Wastewater Management