
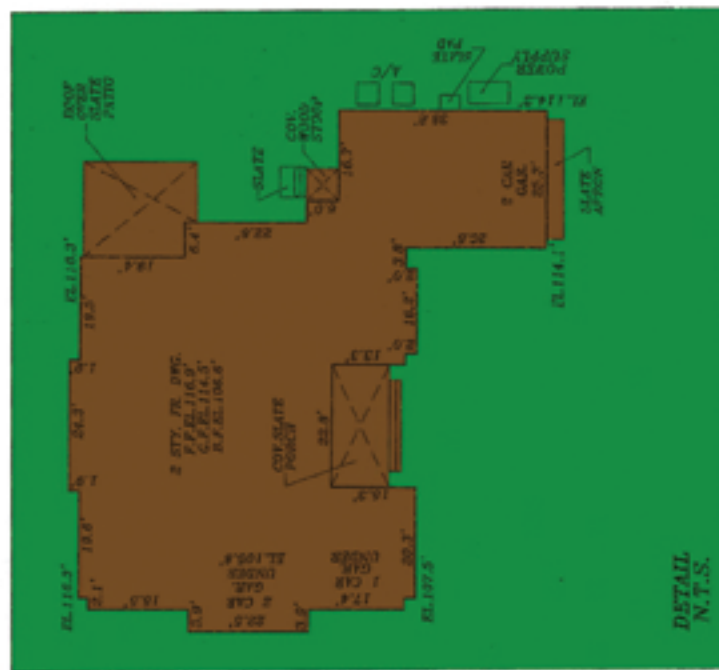


**SURVEY OF DESCRIBED PROPERTY
SITUATED AT
WATERMILL,
TOWN OF SOUTHAMPTON
SUFFOLK COUNTY, NEW YORK**

S.C.T.M. NO. 900-64-2-17.3
AREA = 201.190 SQ. FT./4.61 ACRES
ELEVATIONS ARE IN N.G.V.D. DATUM

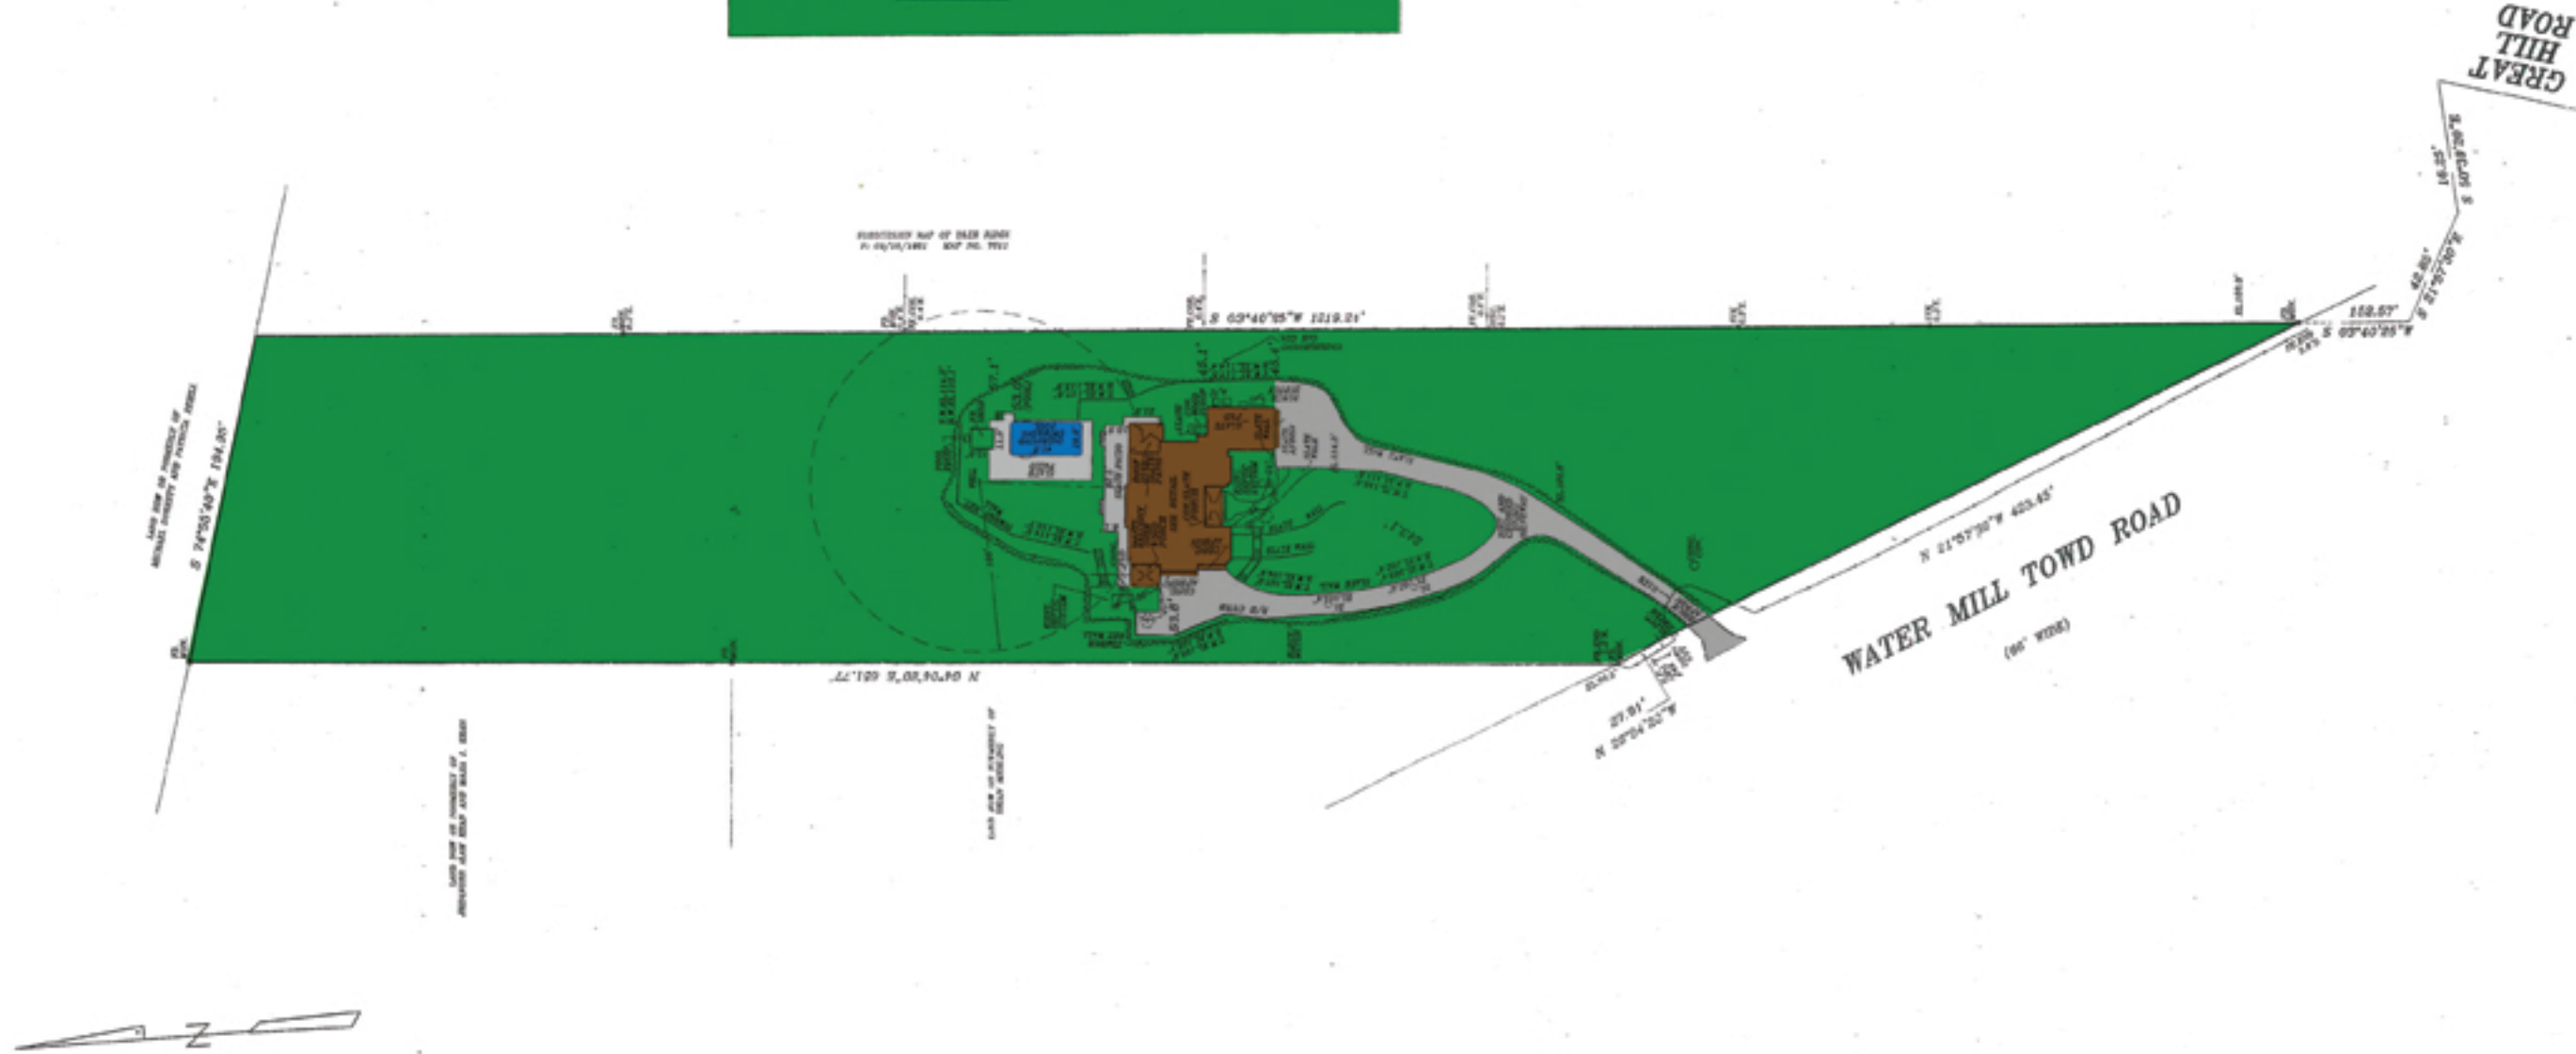

PAT T. SECCAFICO
PROFESSIONAL LAND SURVEYOR, P.C.
- SUCCESSOR TO -

DONALD TASE, L.S.

RICHARD WILHELM AND ASSOCIATES
NORTHSTAR SURVEYING, P.C.

PAUL T. CANALIZO, L.S., ROBERT A. KART, L.S.

GOOD GROUND SURVEYORS, P.C.

328A Main Street
Center Moriches, NY 11934
Phone: (631) 878-0120
Fax: (631) 878-7190

107-5 W. Montauk Highway
Hampton Bays, NY 11946
Phone: (631) 728-5330
Fax: (631) 728-6707

N.Y.S. LIC. NO. 040787