



SITUATE AT
WEST NECK

S.C.T.M. DIST. 0900 SEC. 92 BLK. 02 LOT 19

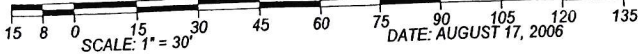

LOT AREA: 17,813 SQ.FT. = 0.409 ACRE

SUBDIVISION MAP OF "WEST NECK SOUTH"
FILED IN THE OFFICE OF THE CLERK OF THE
COUNTY OF SUFFOLK ON OCTOBER 5, 1982
AS MAP NO. 7121

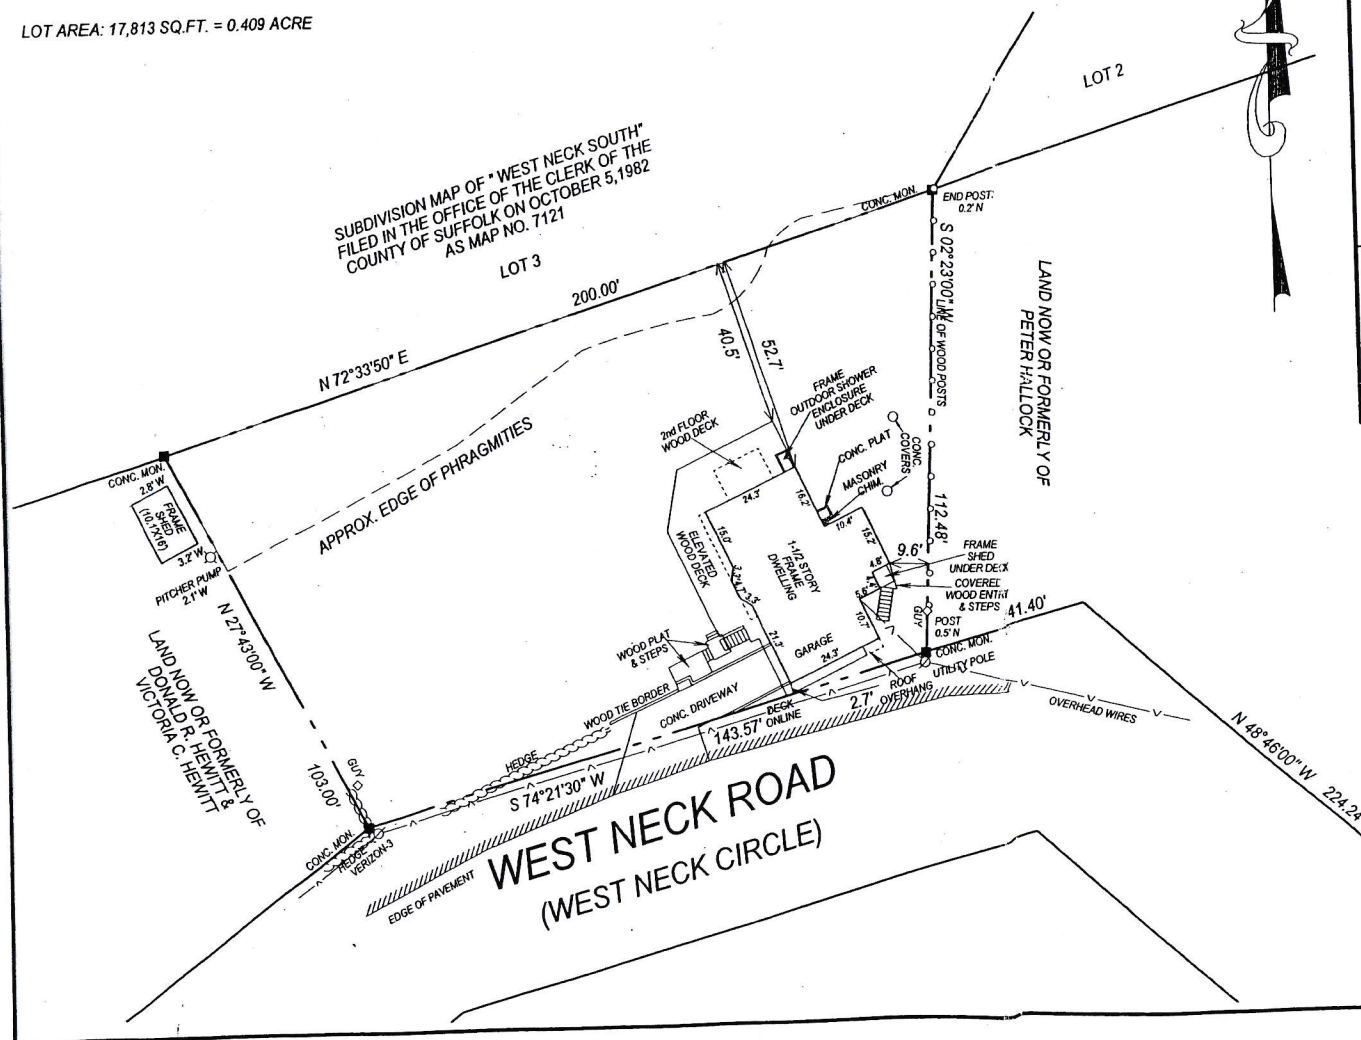

CERTIFIED TO: NEAL OWEN
WILLIAM OWEN
FIRST AMERICAN TITLE INSURANCE CO.
WASHINGTON MUTUAL BANK, PA

JOB NO.: 2006-244
MAP NO.:
FILED:
REVISIONS:



LICENSE NO. 050363

HANDS ON SURVEYING

26 SILVER BROOK DRIVE
FLANDERS, NEW YORK
11901

TEL: (631)-723-1954 - FAX: (631)-723-1329
MARTIN D. HAND L.S



WEST NECK ROAD

ASSIGNMENT AND SURFACE
STRUCTURES INCORPORATED OR
UNINCORPORATED, AND NOT TRANSFERRED
AND NOT PHYSICALLY SEVENTH AT THE
TIME OF SURVEY.

THE OFFICE FOR LANDS/DESIGN DIVISION
OF THE BUREAU OF LAND MANAGEMENT
PROPOSES TO REEVALUATE THE PROPERTY
LIMITS AND FOR A SPECIFIC
PURPOSE, AND FOR THE PURPOSES OF
THE SURVEY, THE BUREAU OF LAND
MANAGEMENT IS NOT INTENDING TO BRIDGE THE
GAP BETWEEN THE SURVEY AND THE
SMALL, POLES, PATROL, PLANTING
AND OTHER STRUCTURES, AND
OTHER STRUCTURES.

UNINCORPORATED ALTERNATION OF ADDITION
TO THIS SURVEY IS A VIOLATION OF
BUREAU OF LAND MANAGEMENT OR
EDUCATION LAW.

COPIES OF THIS SURVEY MAP NOT BEARING
THE BUREAU OF LAND MANAGEMENT
OR EDUCATION LAW SHALL NOT BE CONSIDERED
TO BE A VALID TITLE COPY.

CERTIFICATIONS INDICATED ABOVE SHALL BE
MADE BY THE BUREAU OF LAND MANAGEMENT
PREPARED AND ON HIS OWN BEHALF TO
THE BUREAU OF LAND MANAGEMENT AND
LANDS IN THE BUREAU OF LAND MANAGEMENT
AND LANDS IN THE BUREAU OF LAND MANAGEMENT
TO ADDITIONAL AND ADDITIONAL OR SURVEYED

