

MAP OF LOT 6; BLOCK 206

SUBDIVISION NO. 8

MONTAUK BEACH DEVELOPMENT CORP.

East Portion of North Downs Residential Section

Filed May 6, 1927 as Map no. 1018

SITUATE

MONTAUK, TOWN OF EAST HAMPTON

SUFFOLK COUNTY, N.Y.

SCALE: 1"=30'


TAX MAP REF. 0300-19-02-02

LOT AREA: 14,212.74 SQ FT OR

CERTIFIED TO: 0.326 ACRES

LORRI STRONG

EASEMENTS, RIGHT OF WAYS
UNDERGROUND UTILITIES AND/OR
SANITARY FACILITIES NOT VISIBLE
AT THE TIME OF SURVEY HAVE NOT
BEEN SHOWN, LOCATED AND/OR
MEASURED BY OTHERS

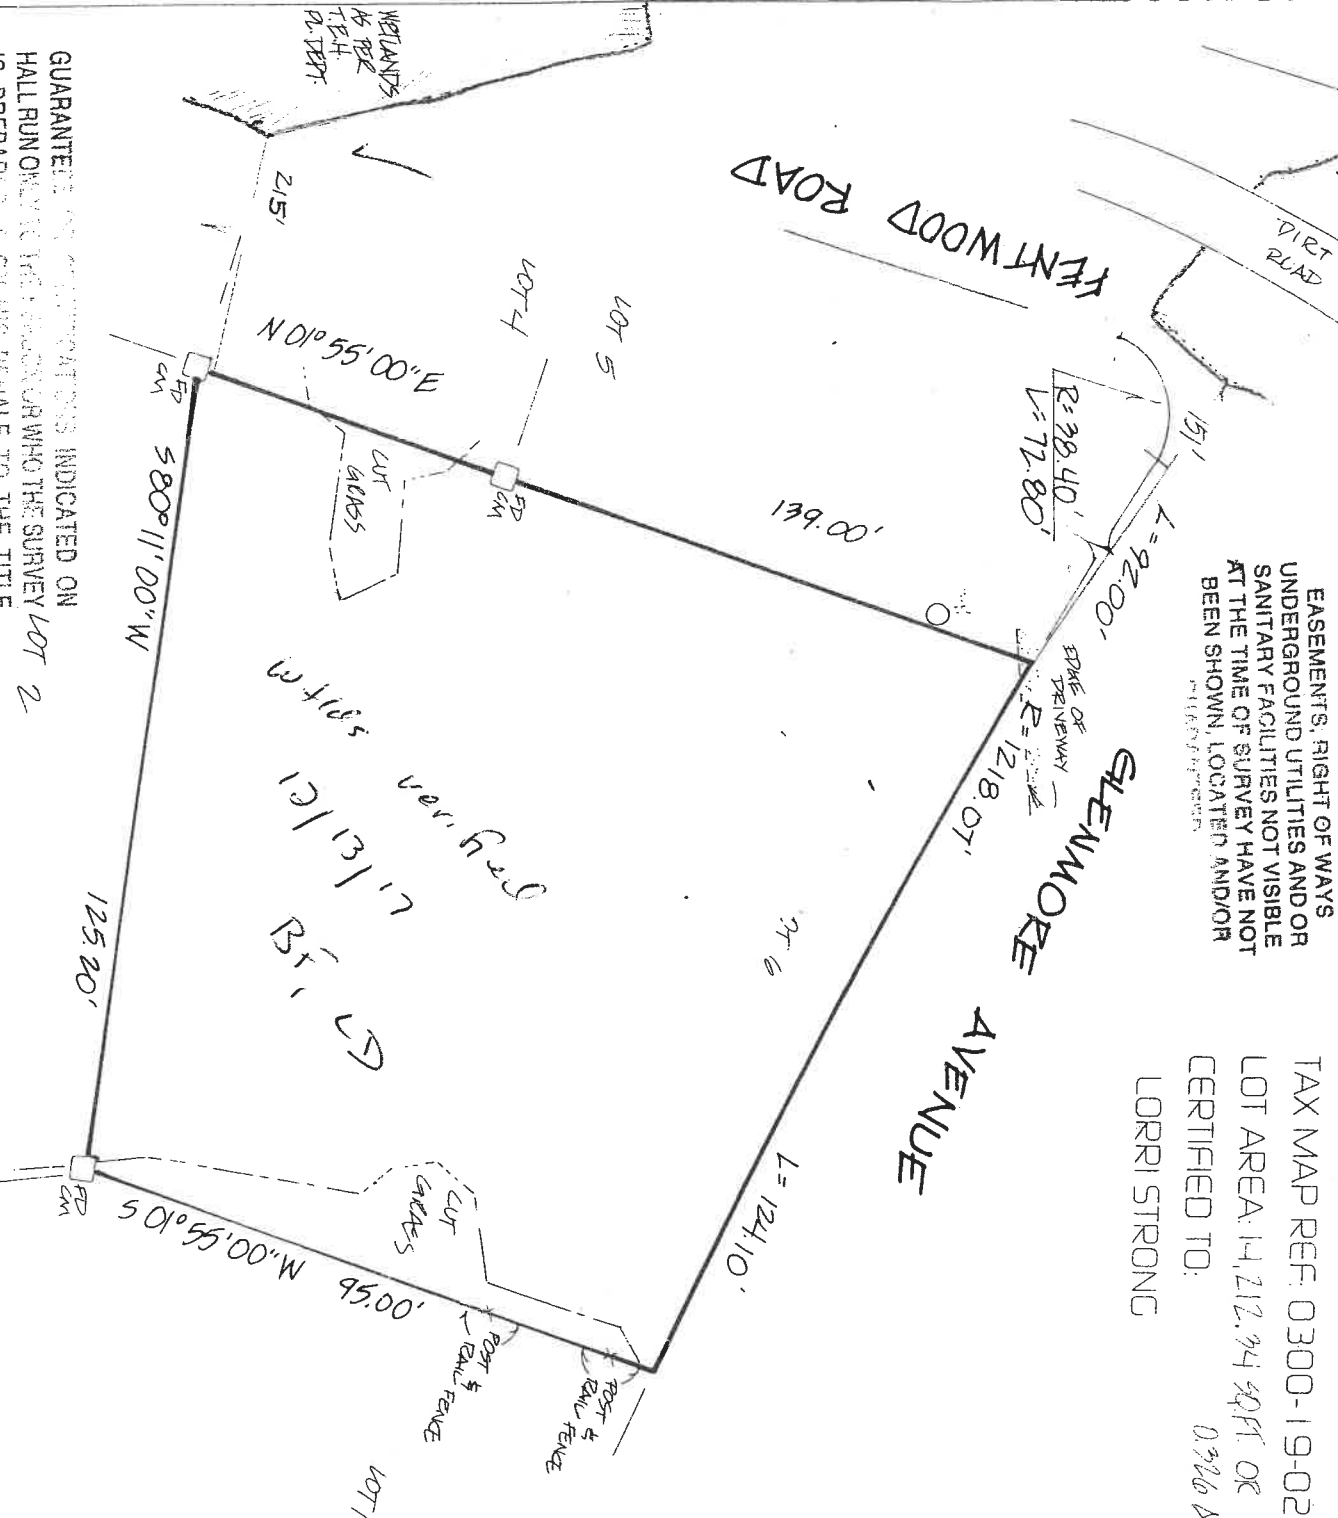

GUARANTEES OR CERTIFICATIONS INDICATED ON
HALL RUN OR STATE THE PERSON WHO THE SURVEY LOT 2
IS PREPARED BY ON BEHALF TO THE TITLE
COMPANY GOT BOUNDARY AGENCY & LENDING
INSTITUTIONS LENDING INSTITUTION & TO THE ASSIGNEES
OF THE LENDING INSTITUTION, GUARANTEES OR
CERTIFICATIONS ARE NOT TRANSFERABLE TO
ADDITIONS OR SUBSEQUENT CHANGES


REVISED MAY 8, 2001 WJD

SURVEYED FEBRUARY 7, 2001

WILLIAM J. WALSH,

LAND SURVEYOR

MONTAUK, N.Y.

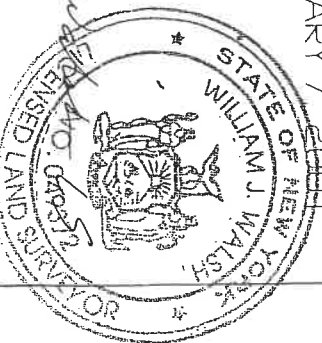

19-2-2