


HANDS CREEK TO ELY BROOK RD.

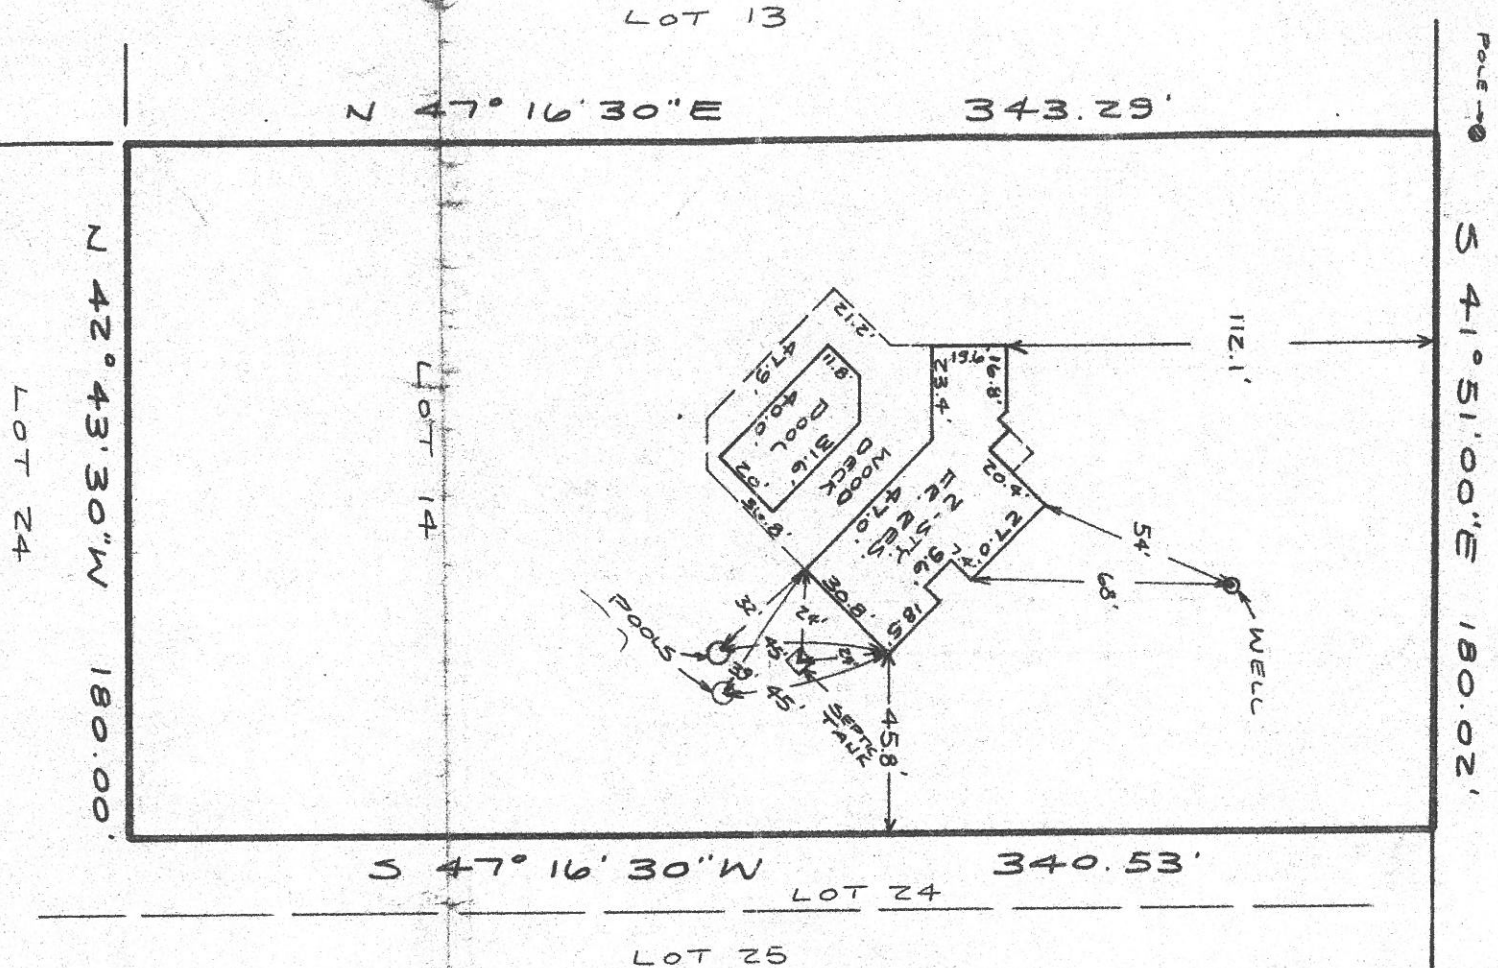

SUFFOLK COUNTY HEALTH DEPARTMENT
SINGLE FAMILY DWELLING ONLY

H.D. REF. NO. 85-EH-210
DATE SEP 04 1986

THE SEWAGE DISPOSAL AND WATER SUPPLY FACILITIES FOR THIS LOCATION HAVE BEEN INSPECTED BY THIS DEPARTMENT AND FOUND TO BE SATISFACTORY.

Stephen A. Costa, P.E.
Chief of Wastewater Management Section

RE-DATED JULY 1, 1986 (FINAL)

Prepared in accordance with the minimum standards of the New York State Land Title Association.

Certification indicated hereon shall run only to the person for whom the survey is prepared, and on his behalf to the title company, governmental agency and lending institution listed hereon, and to the assignees of the lending institution. Certification is not transferable to additional institutions or subsequent owners.

Unauthorized alteration or addition of this survey is a violation of Section 7209 of the New York State Education Law.

Copies of this survey map not bearing the Land Surveyors inked seal or embossed seal shall not be considered to be a valid true copy.

The offsets (or dimensions) shown hereon from the structures to the property lines are for a specific purpose and use and therefore are not intended to guide the erection of fences, retaining walls, pools, patios, planting areas, additions to buildings or any other construction.

MAP OF PROPERTY
SITUATE NORTHWEST
TOWN OF EAST HAMPTON
Suffolk County, N. Y.
SURVEYED MAY 13, 1985
FOR BARNETT BROWN
CERTIFIED TO: — NOT TRANSFERABLE
EQUITY ABSTRACT

DONALD J. TASE, L.S.
— SUCCESSOR TO —
RICHARD WILHELM AND ASSOCIATES
LICENSED LAND SURVEYORS
Center Moriches, N. Y. 11934 Brentwood, N. Y. 11717
Tel. 878-0120 Tel. 273-8163
PER Donald J. Tase L.S.
Authorized Signature

Measurements U.S. Standard
Scale 1" = 50'
Monuments Shown Thus
Stakes Shown Thus