


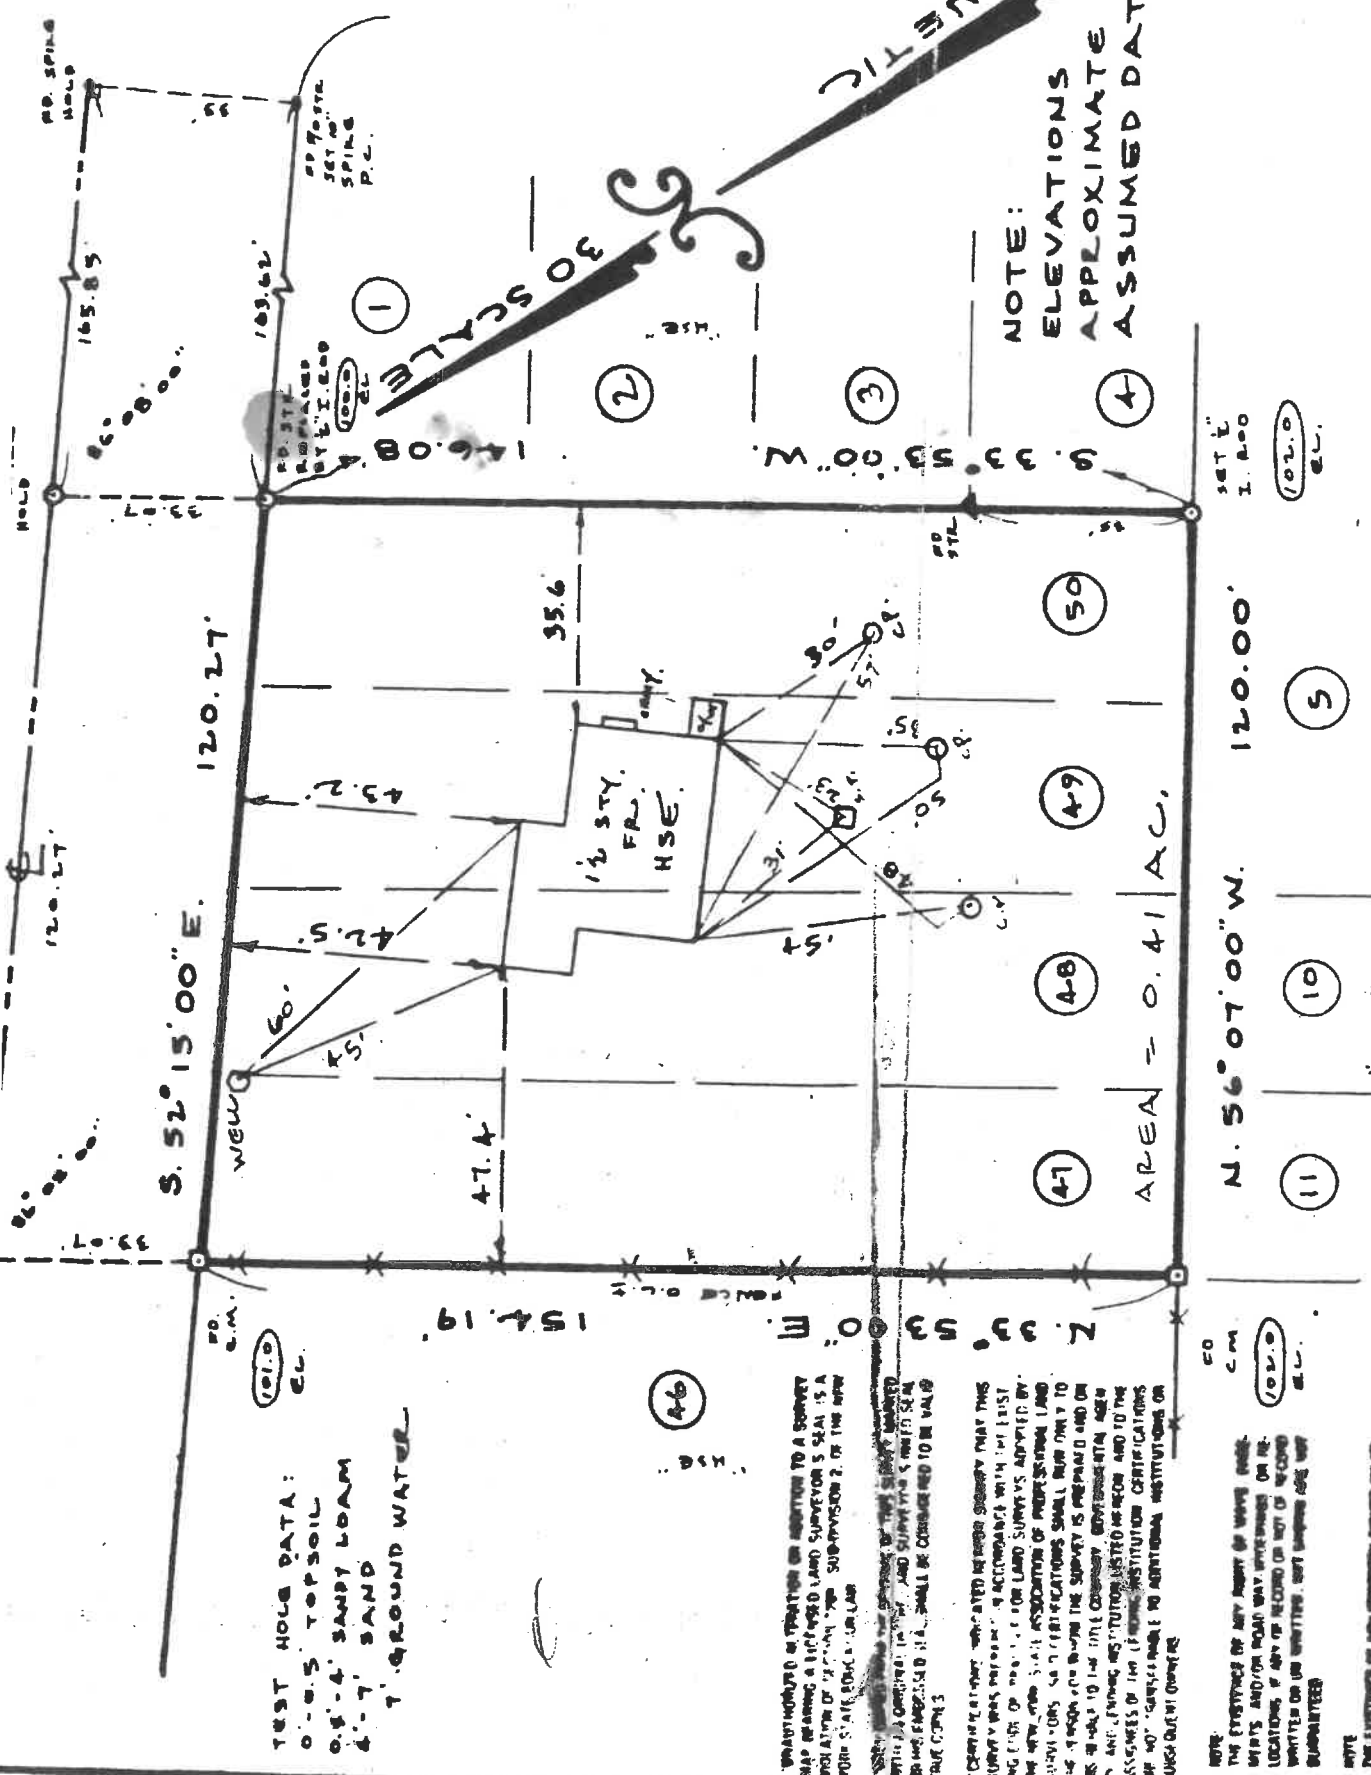

TEST HOLE DATA:
 0'-0.5' TOP SOIL
 0.5'-4' SANDY LOAM
 4'-7' SAND
 7' GROUND WATER

46

UNNOTICED OR UNKNOWN TO THE SURVEYOR THAT THIS MAP BEARING A SURVEYOR'S SEAL IS A VIOLATION OF THE SURVEYING ACT, 1901, AND THE SURVEYOR IS NOT RESPONSIBLE FOR THE SAME.

THE SURVEYOR'S CERTIFICATE OF THIS SURVEY BEARING HIS SEAL AND SIGNATURE IS A VALID AND SUFFICIENT EVIDENCE OF THE ACCURACY OF THE SAME.

NOTE: THE EXISTENCE OF ANY RIGHT OF WAY, EASE, OR OTHER INTEREST IN THE LAND SHOWN ON THIS MAP IS NOT GUARANTEED BY THE SURVEYOR.

NOTE: THE EXISTENCE OF ANY RIGHT OF WAY, EASE, OR OTHER INTEREST IN THE LAND SHOWN ON THIS MAP IS NOT GUARANTEED BY THE SURVEYOR.

MAP OF LOTS 47-50 INCL. BLOCK 2 SUBDIVISION MAP OF

NOTE:
 ELEVATIONS
 APPROXIMATE &
 ASSUMED DATUM.

30 SCALE

MAGNETIC

THE OFFSETS FOR DIMENSIONS SHOWN HEREON FROM THE STRUCTURES TO THE PROPERTY LINES ARE FOR A SPECIFIC