

1422-A3202

Suffolk County Tax Map
District 0000
Section 070
Block 010A
Parcel 000,000

Monument
Steel Pin

Commonwealth Land Title Insurance Co.

Surveyed May 9, 1896

John Holden
Lester Holden, L.S. #49548

S.E.W. & S. Land Surveyors, P.C.
Bogues, Holden, Wolszenbacher & Smith
Land Surveyors—Engineers
Southampton, N.Y.




Lumber Lane

Narrow Lane

Bridgehampton
Town of Southampton
Suffolk County, N.Y.

7,342 Sq. Ft. (0.169 Acre)

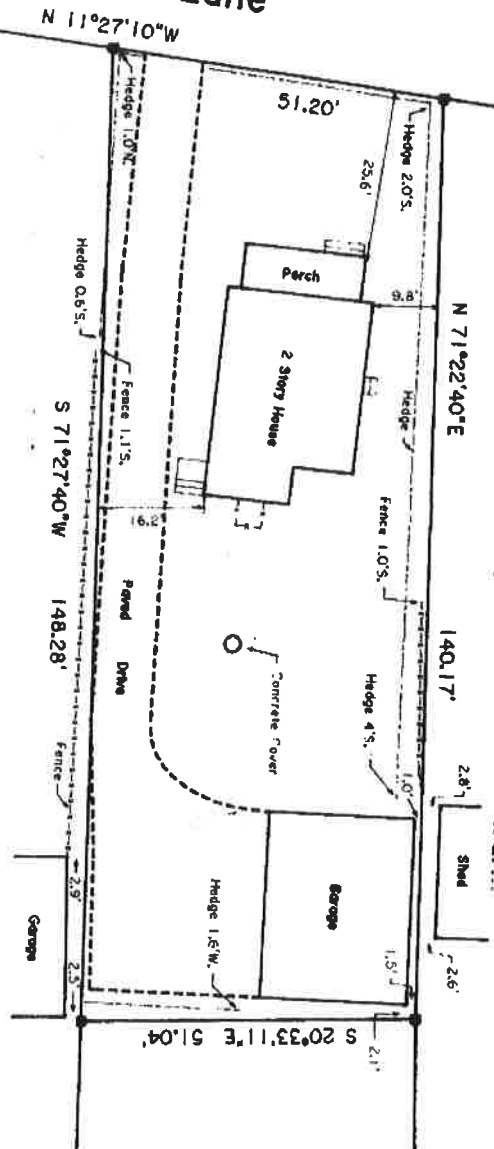

1°-20'