


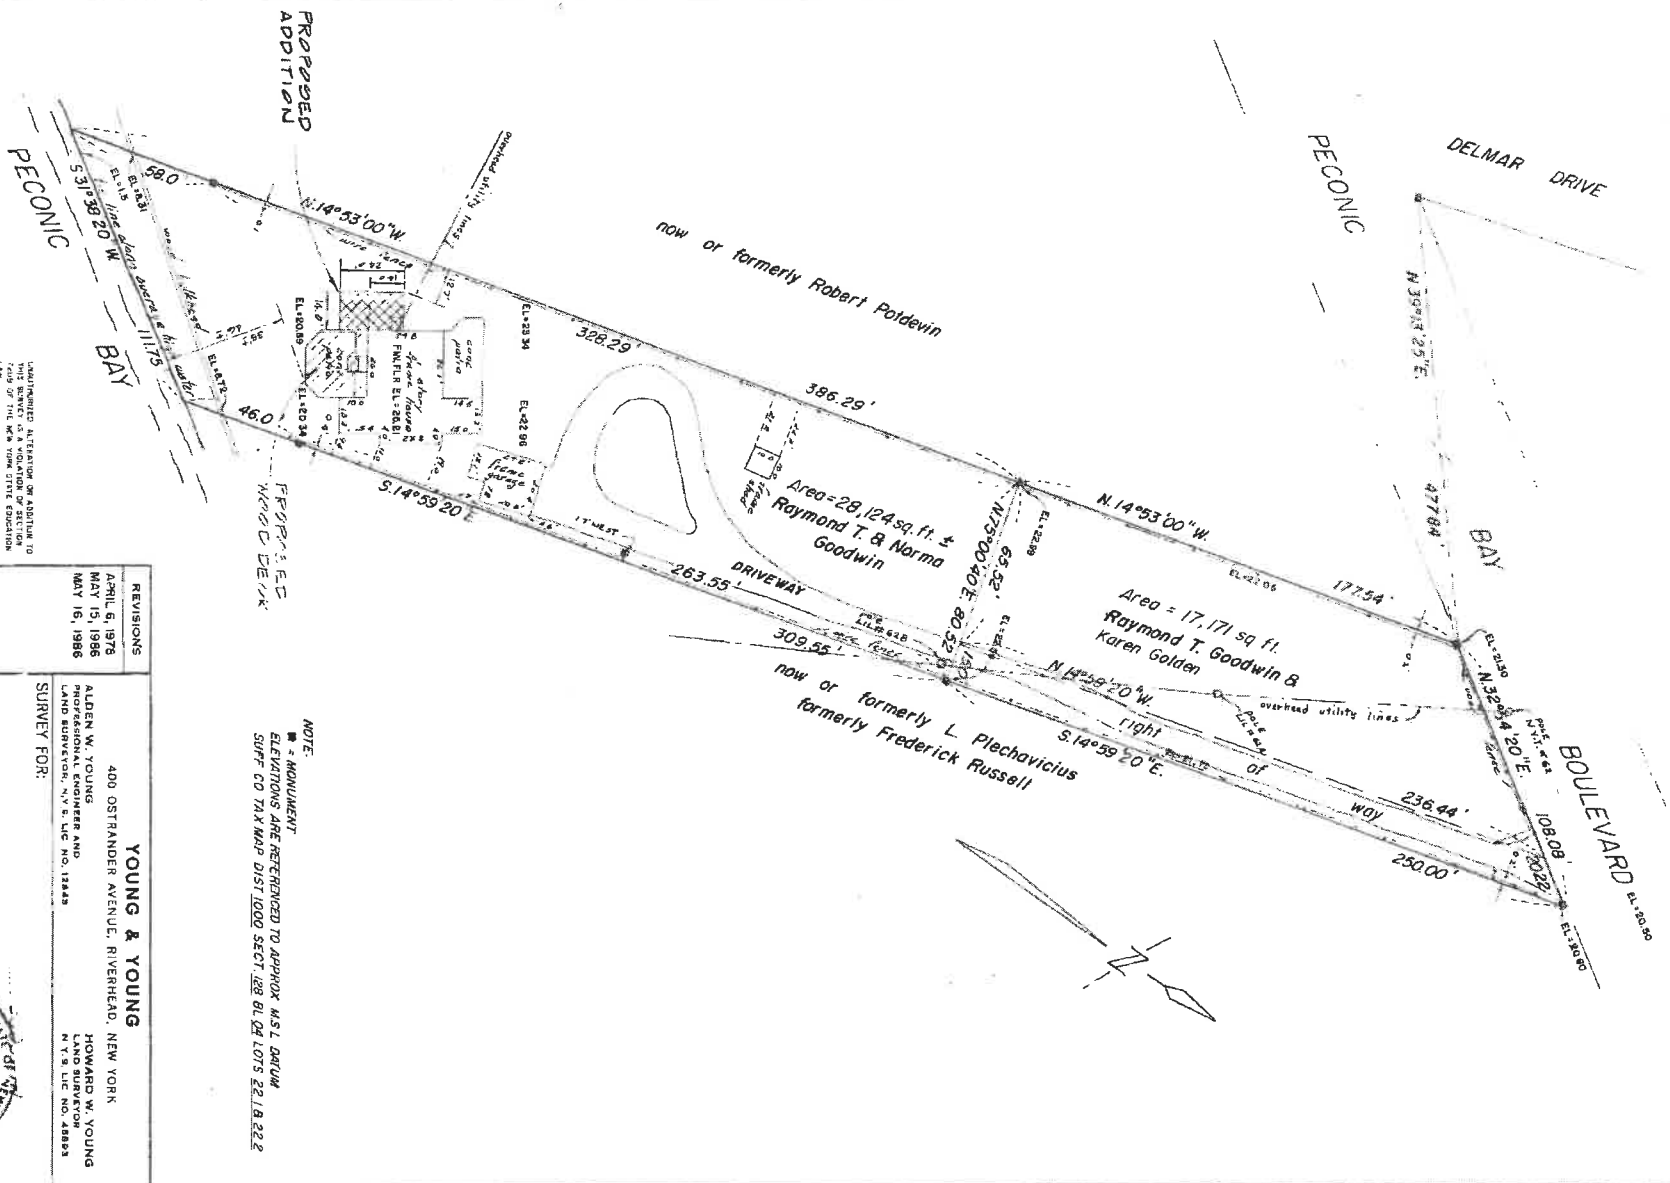

REVISIONS
APRIL 5, 1978
MAY 15, 1986
MAY 16, 1986

YOUNG & YOUNG
400 OSTRANDER AVENUE, RIVERHEAD, NEW YORK
ALDEN W. YOUNG
PROFESSIONAL ENGINEER AND
LAND SURVEYOR, N.Y.S. LIC. NO. 13443

SURVEY FOR:
AT **LAUREL**
TOWN OF **SOUTHOLD**
SUFFOLK CO., N.Y.
DATE **JAN 27, 1978**

UNLIMITED ALTERATION OR ADDITION TO THIS SURVEY IS A VIOLATION OF SECTION 130-A OF THE NEW YORK STATE EDUCATION LAW.
NOTES: 1. THIS SURVEY WAS NOT BEARING FOR THE NEW YORK STATE EDUCATION LAW.
2. THE SURVEY WAS NOT BEARING FOR THE NEW YORK STATE EDUCATION LAW.
3. THE SURVEY WAS NOT BEARING FOR THE NEW YORK STATE EDUCATION LAW.
4. THE SURVEY WAS NOT BEARING FOR THE NEW YORK STATE EDUCATION LAW.
5. THE SURVEY WAS NOT BEARING FOR THE NEW YORK STATE EDUCATION LAW.
6. THE SURVEY WAS NOT BEARING FOR THE NEW YORK STATE EDUCATION LAW.
7. THE SURVEY WAS NOT BEARING FOR THE NEW YORK STATE EDUCATION LAW.
8. THE SURVEY WAS NOT BEARING FOR THE NEW YORK STATE EDUCATION LAW.
9. THE SURVEY WAS NOT BEARING FOR THE NEW YORK STATE EDUCATION LAW.
10. THE SURVEY WAS NOT BEARING FOR THE NEW YORK STATE EDUCATION LAW.

