


OD DISTRICT

JOB No. 13328~ d6624

SUFFOLK COUNTY TAX MAP

DISTRICT	0904
SECTION	5.00
BLOCK	03.00
PARCEL	024.000

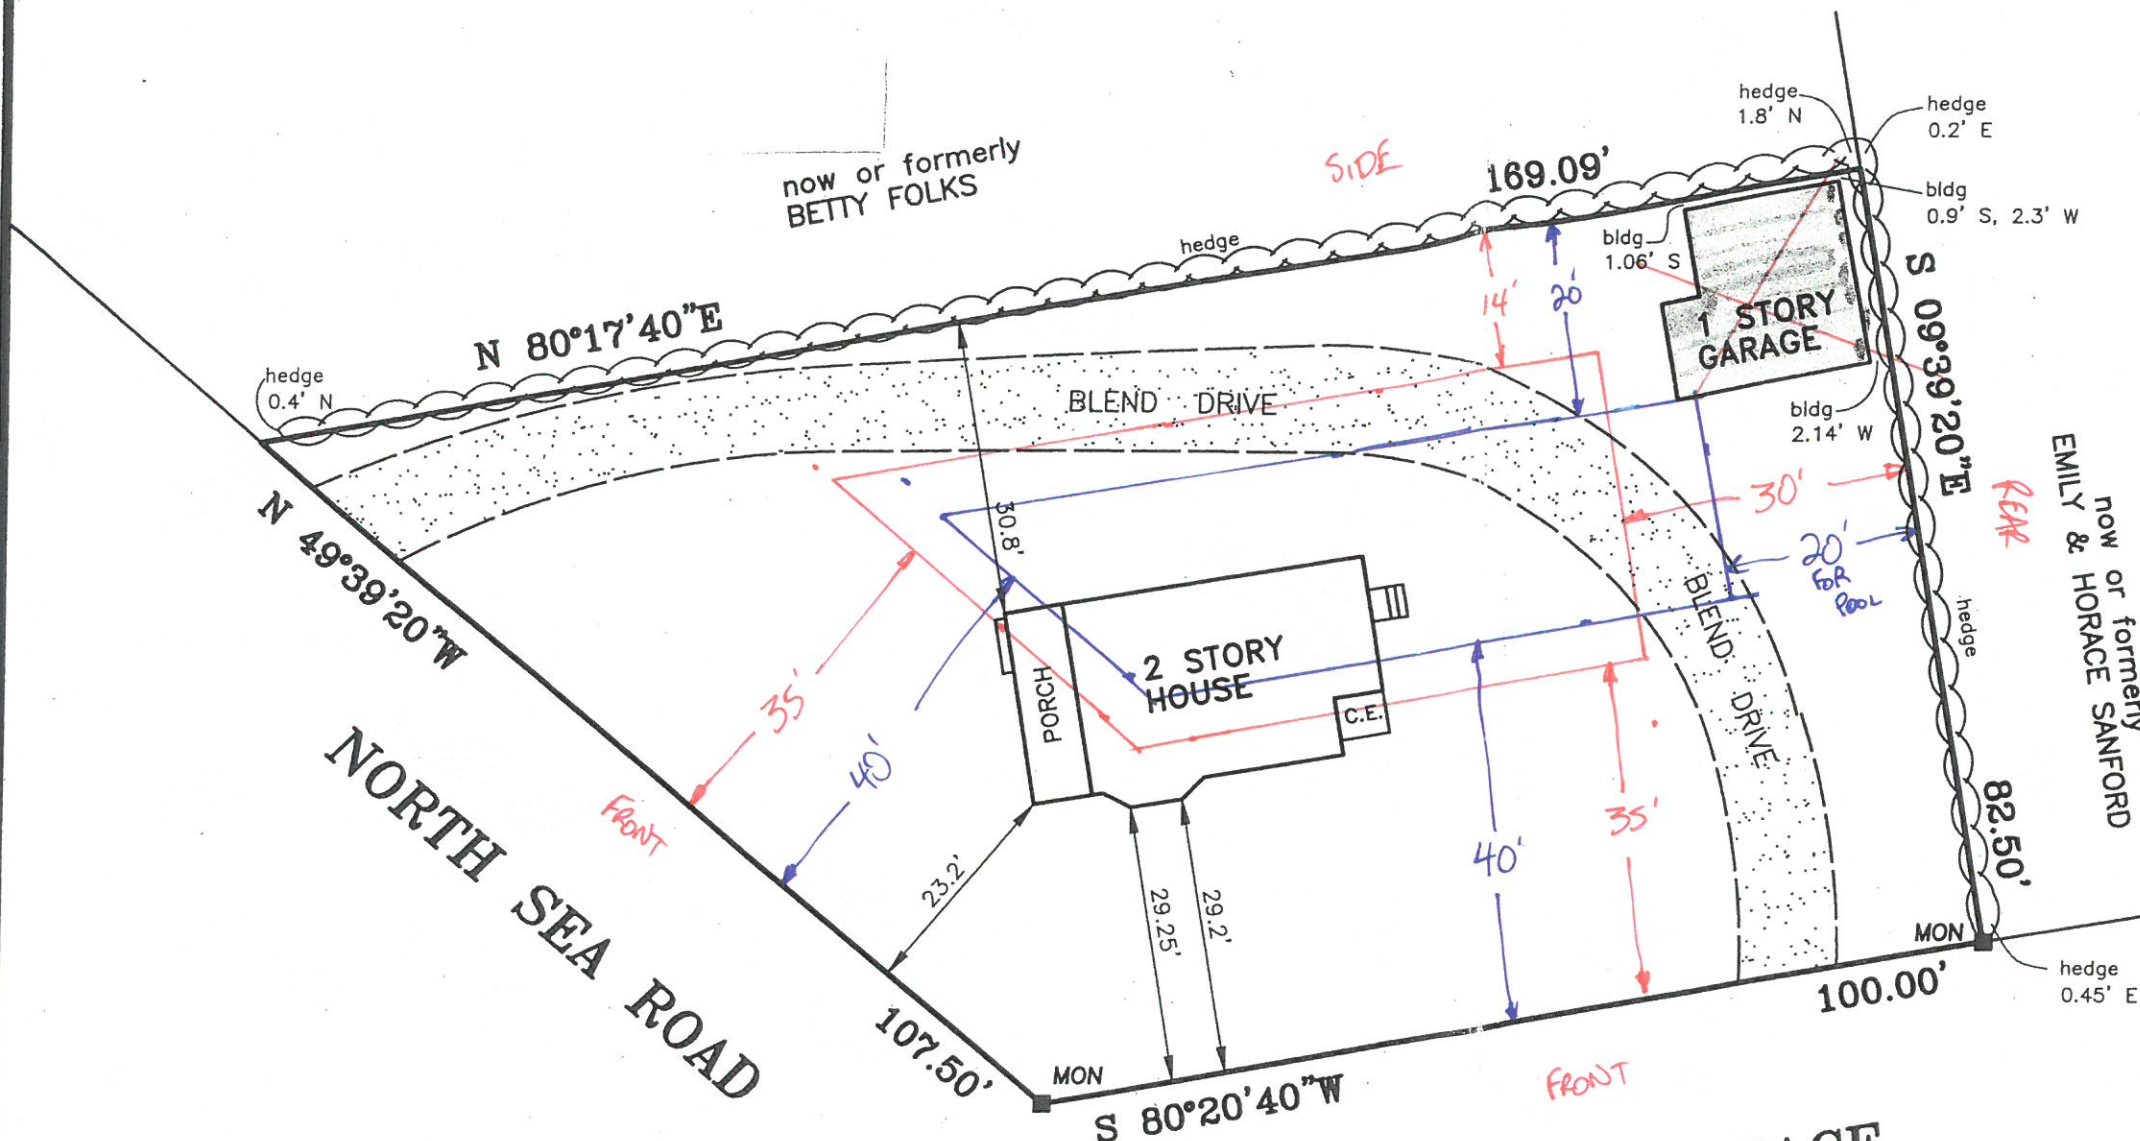

4/10's RELIEF = 33' TOTAL SIDE  
14' MIN SIDE



*[Signature]*  
 APPROVED  
 BUILDING INSPECTOR  
 DECEMBER 15 2005  
 BP# 8985

SURVEYED: OCTOBER 29, 2001  
*[Signature]*

KARL W. WEISENBACHER, L.S. No. 36195  
 S. H. W. & S. LAND SURVEYORS P.C.

**SQUIRES, HOLDEN, WEISENBACHER & SMITH**

LAND SURVEYORS ~ ENGINEERS  
 SOUTHAMPTON ~ NEW YORK

**SANFORD PLACE**

MAP OF PROPERTY  
 FOR  
**TERRI J. GAINES**  
 SITUATE  
**INC. VILLAGE OF SOUTHAMPTON**  
 TOWN OF SOUTHAMPTON  
 SUFFOLK COUNTY, NEW YORK

AREA = 11,092 S.F.  
 SCALE: 1" = 20'