


PROPERTY LOCATED AT EAST MORICHES
IN THE TOWN OF BROOKHAVEN, COUNTY OF SUFFOLK,
AS SHOWN ON SUFFOLK COUNTY LAND & TAX MAP,
DISTRICT 0200, SECTION 890.00, BLOCK 03.000, LOT 007.000..

Scale: 1 inch = 40 feet


ADELAIDE

AVENUE

7148-Bros-97.
A

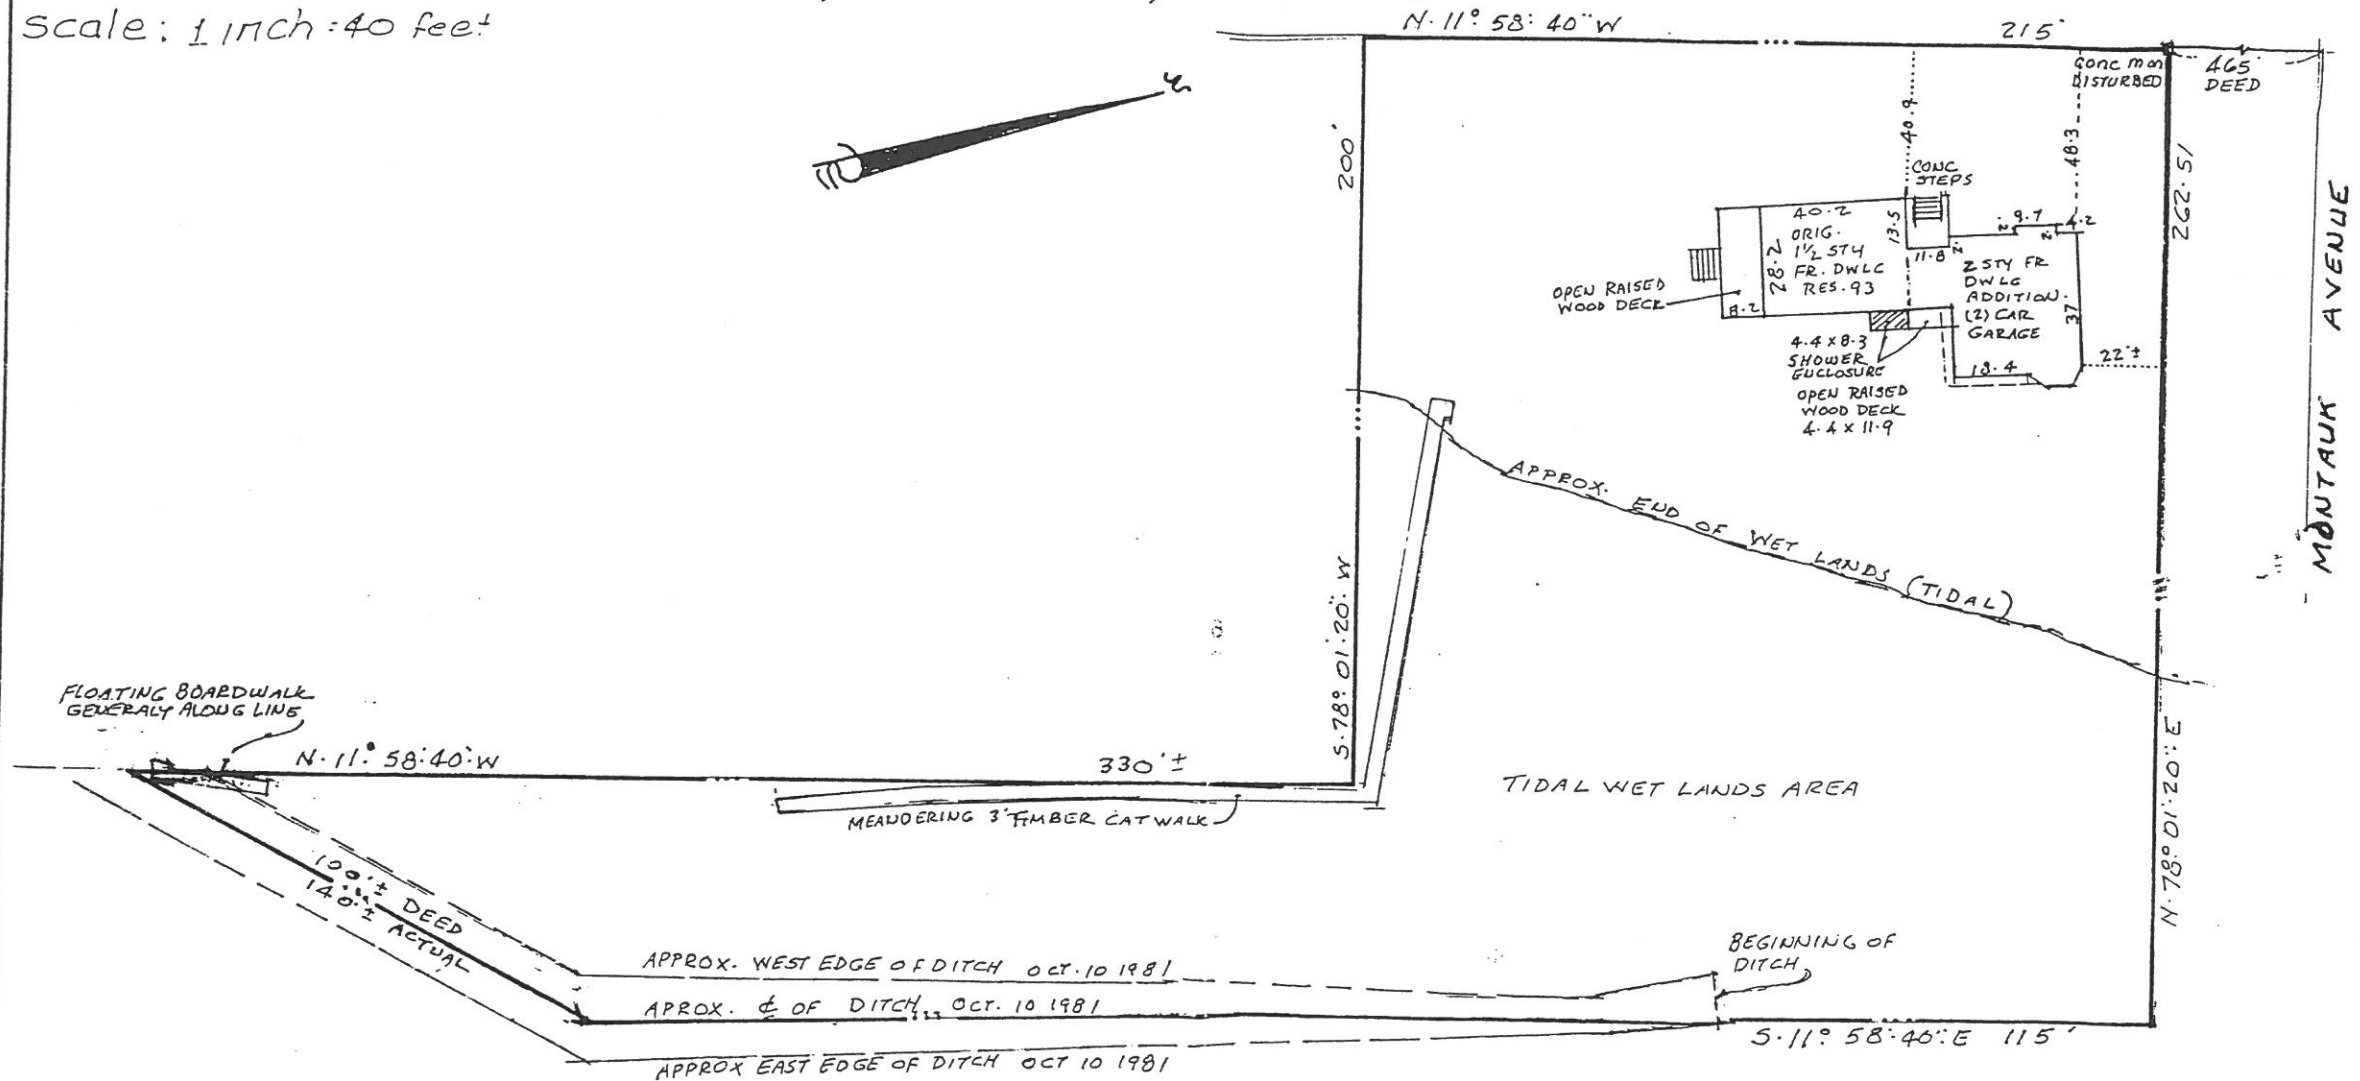

ALL RIGHTS RESERVED

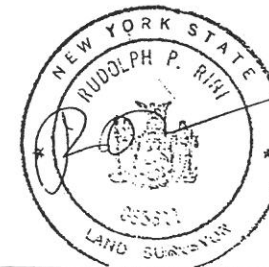

RUDOLPH RINI
N.Y.S. LAND SURVEYOR
218 N. WELLWOOD AVE.
LINDENHURST, L.I., N.Y.
MEASUREMENTS OF ADDITIONS FOR
C.O. PURPOSES ONLY.
SEPT 16 1997

COPIES OF PLAN NOT BEARING THE SURVEYORS INKED SEAL ARE INVALID.
UNAUTHORIZED ALTERATIONS AND/OR ADDITIONS TO PLAN VIOLATES SEC. 7209.2 OF THE N.Y.S. EDUCATION LAW.
102:49 91:08 78:106 (7148-Bros-87) (2560 Bros-31)

97112