




NOTE: GAZEBO MUST BE ANCHORED TO FOUNDATION OR TIE DOOWNS Lot 43

PHEASANT POND
APPROX. SHORE LINE

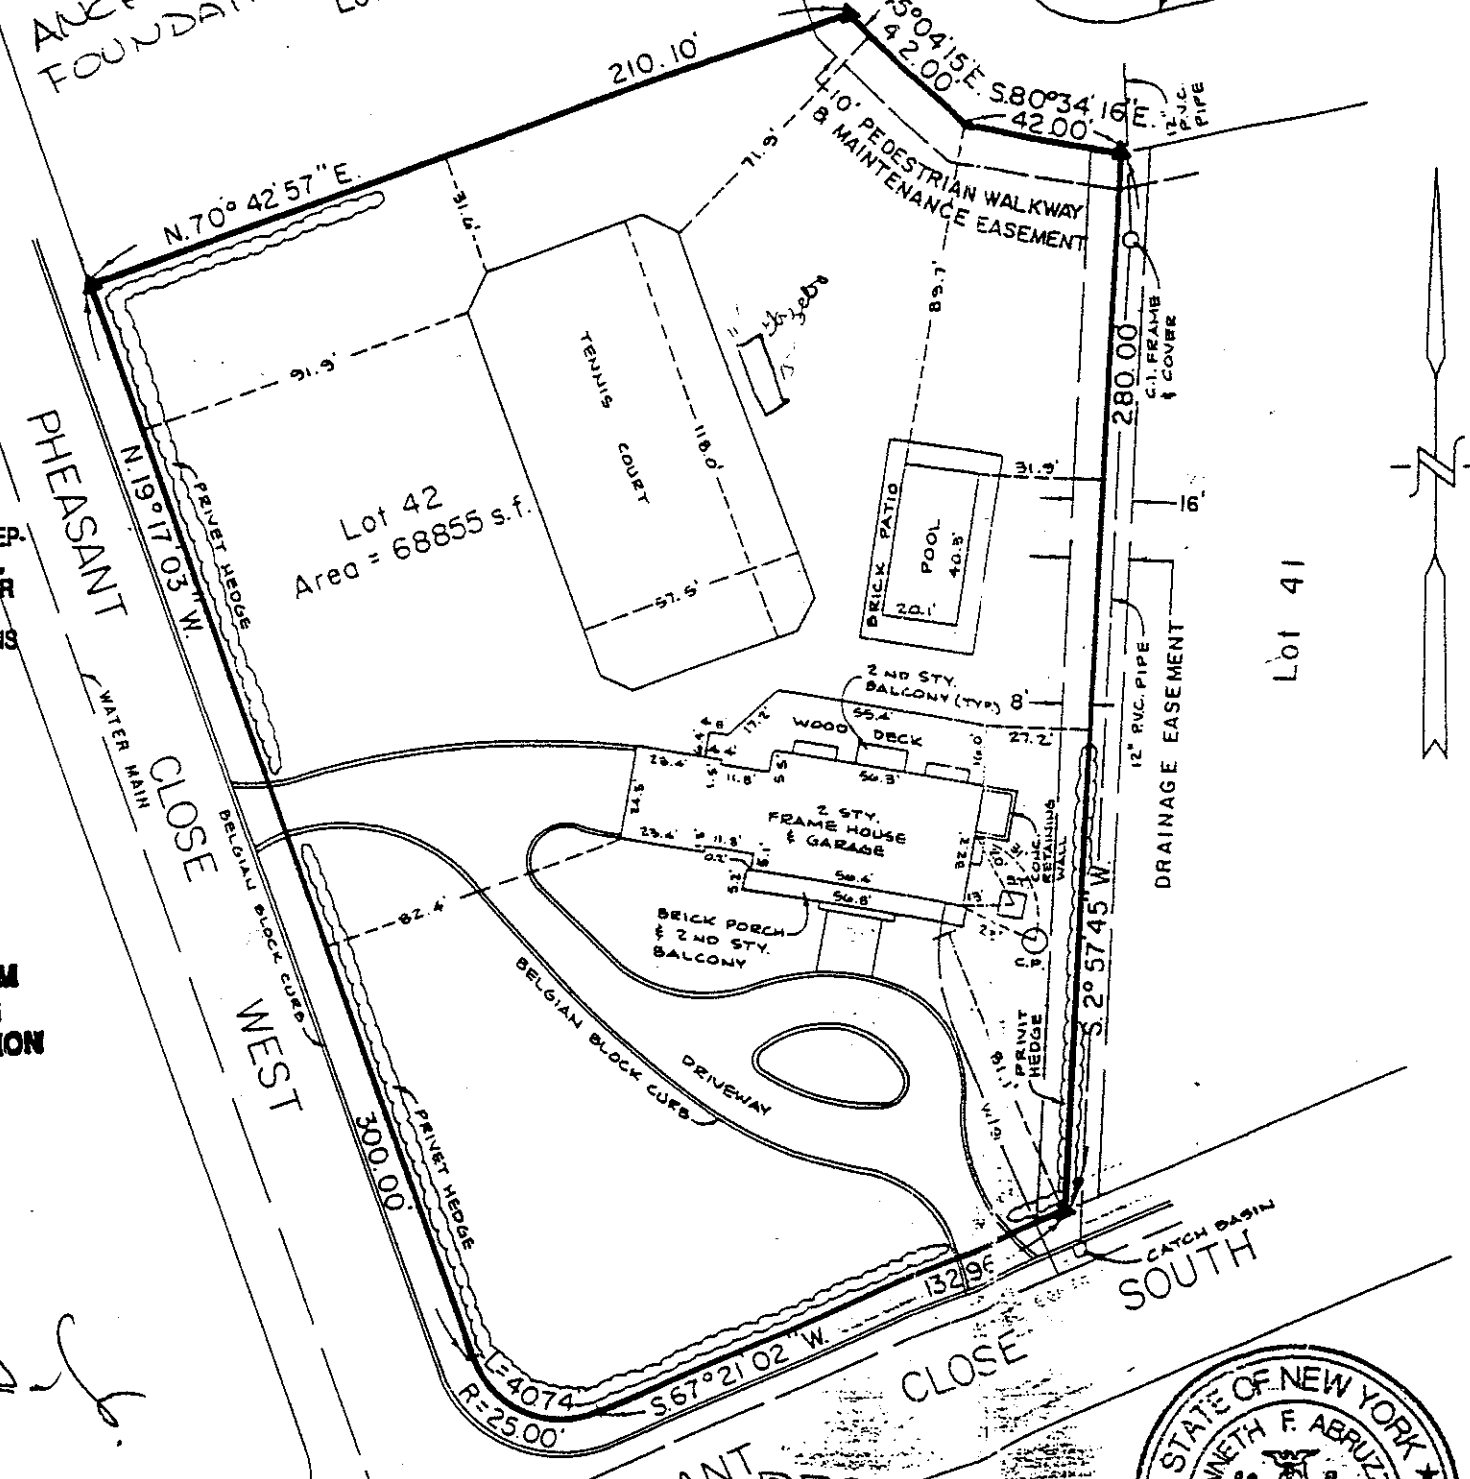


FOR OR COMMISSION ON THE PART OF THE BUILDING INSPECTOR OR HIS REPRESENTATIVE SHALL LEGALIZE THE ERECTING, CONSTRUCTION ALTERATION REMOVAL USE OR OCCUPANCY OF A BUILDING OR STRUCTURE THAT DOES NOT CONFORM TO THE PROVISIONS OF THE N.Y. STATE BUILDING CODE AND THE BUILDING ZONE ORDINANCE.

COMPLY WITH NY STATE UNIFORM FIRE PREVENTION AND BUILDING CODE AND ENERGY CONSERVATION CONSTRUCTION CODE

6163
APPROVED
BUILDING INSPECTOR
E. Wolpert
9/12/96

NOTE: ▲ = STAKE FOUND
SUBDIVISION MAP FILED IN THE OFFICE OF THE CLERK OF SUFFOLK COUNTY ON NOV. 25, 1986 AS FILE NO. 8221.

RECEIVED
JUN 8 1995

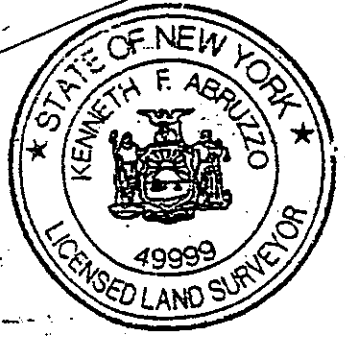

S.C. DEPT. OF HEALTH SERVICES

Young & Young, Land Surveyors
400 Ostrander Avenue, Riverhead, New York 11901
516-727-2303

Alden W. Young, Professional Engineer & Land Surveyor
Howard W. Young, Land Surveyor
Thomas C. Wolpert, Professional Engineer

SUFFOLK COUNTY DEPARTMENT OF HEALTH SERVICES
SINGLE FAMILY DWELLING ONLY
Approval of Constructed Works
Date JUN 13 1995 H.S. Ref. No. 93SH 65
The sewage disposal and water supply facilities at this location have been inspected and/or certified by this Department or other agencies and found to be satisfactory.
Stephen A. Costa
Stephen A. Costa, P.E., Chief
Office of Water and Wastewater Management

SUFFOLK COUNTY DEPARTMENT OF HEALTH SERVICES CERTIFICATION
"I AM FAMILIAR WITH THE STANDARDS FOR APPROVAL AND CONSTRUCTION OF SUBSURFACE SEWAGE DISPOSAL SYSTEMS FOR SINGLE FAMILY RESIDENCES AND WILL ABIDE BY THE CONDITIONS SET FORTH THEREIN AND ON THE PERMIT TO CONSTRUCT."

APPLICANT'S SIGNATURE: _____
APPLICANT: Kenneth J. Tedaldi
STREET ADDRESS: Box 815, 130 Jessup Ave
CITY: Quogue, New York 11959 ZIP CODE: _____
TELEPHONE NUMBER: _____

SURVEY FOR:
KENNETH J. TEDALDI ROLLOVER IRA F-80
LOT NO. 42, "PHEASANT CLOSE"
At: INC. VILLAGE OF SOUTHAMPTON S 25
Town of: SOUTHAMPTON S (25/65)
Suffolk County, New York Corner 80
R 100
Suff. Co. Tax Map: 904 20 2 27.91
District Section Block Lot

CERTIFIED TO:
FIRST AMERICAN TITLE INSURANCE COMPANY OF NEW YORK
NORTH FORK BANK & TRUST COMPANY
CITIBANK, N.A.
KENNETH J. TEDALDI ROLLOVER IRA
Kenneth F. Abruzzo
DATE: JUNE 1, 1995
APR. 25, 1995
SCALE: 1" = 50'
JOB NO.: 94-0727
SHEET NO.: 1 OF 1

UNAUTHORIZED REPRODUCTION OR ALTERATION OF THIS SURVEY MAP NOT BEARING THE SEAL OF THE SURVEYOR IS PROHIBITED AND IS A VIOLATION OF SECTION 7209 OF THE VESSEL CODE AND PENALTY THEREFOR IS \$500.00 PER COPY. THE LOCATION OF WELLS OR SPRINGS IS NOT SHOWN ON THIS MAP AND IS NOT TO BE CONSIDERED.