


2.5-5.0	Pink Brown fine to coarse sand
5.0-6.0	Grey clay
6.0-7.2	Brown clayey sand
7.2-11.1	Water
	2.5 ft. clayey sand

FROM CHRIS HARMON
 RE - CONRAD
 SURVEY SHOWS DECKS
 ON SIDE IN 1989 -
 REMOVED AS PER Z.B.A.

MAP OF PROPERTY
 Situate
THREE MILE HARBOUR

Town of East Hampton, Suffolk Co., N.Y.
 Scale: 1" = 50'
 AREA = 21,338 Sq. Ft. to TIC LINE
 "A" Zone
 Flood Zone "AB"
 Guaranteed to:
 Bern Conrad
 Ilonka Conrad

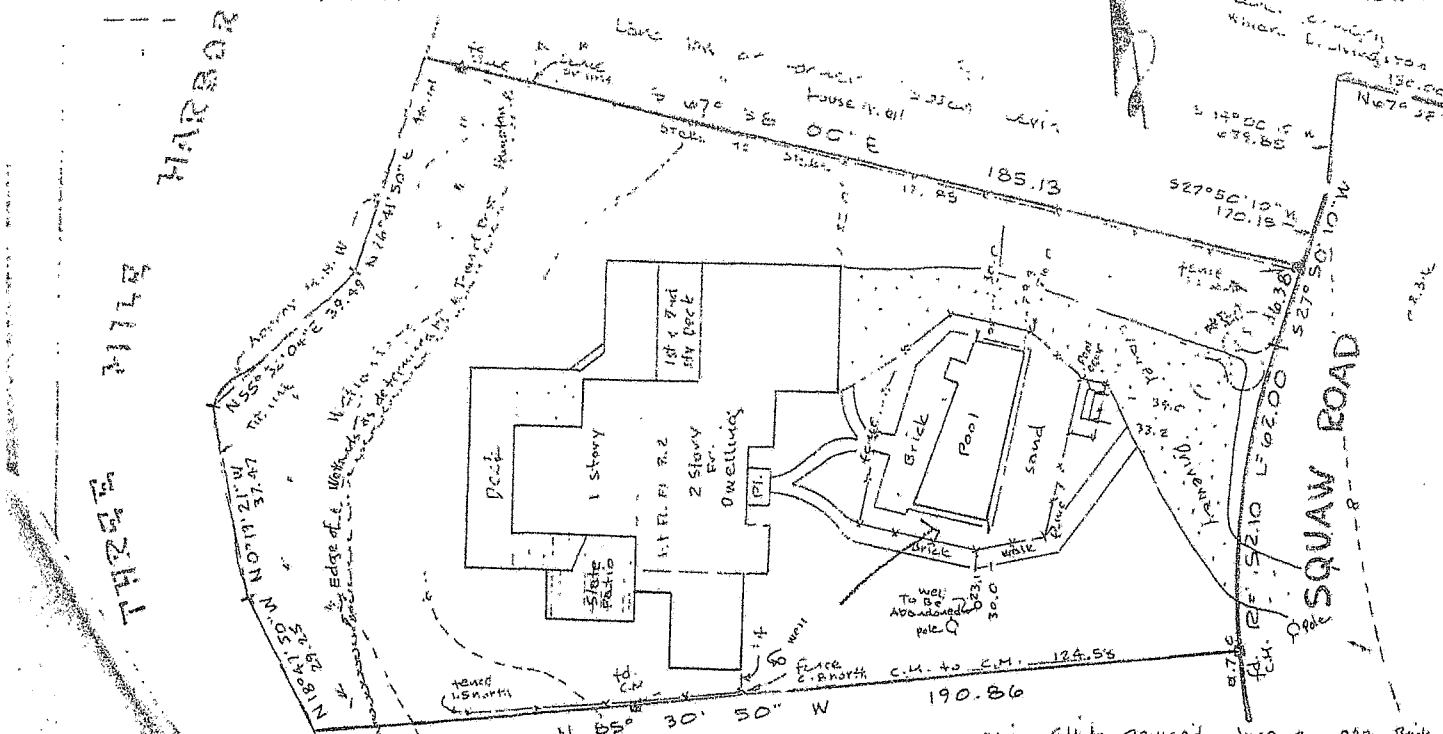

S.C.E.G.S.
 existence of right of ways,
 and/or easements of record,
 shown are not guaranteed.
 10-75-01-09

Land now or formerly Lillian Gill
 House/Well & Sani. over 100'
 Revised: March 7, 1994 - Brick

Revised: June 8, 1993 - Brick, wells
 Revised: May 24, 1993 - Walls, Well
 Revised: Feb. 18, 1993 - final Ho. Pool, Deck
 Revised: July 8, 1992 - Ste. Pool, Sani.
 Revised: Nov. 6, 1990 - Prop. Pool, Sani.
 Revised: Aug. 16, 1990 - Prop. Pool
 Revised: July 12, 1990 - Prop. Add. Bol. Sani.

Revised: Sept. 21, 1989 - Ext. Wetlands stuff
 Surveyed: July 17, 1989

GEORGE H. WALBRIDGE
 Land Surveyors & Land Planners
 East Hampton, Long Island, N.Y.