

SURVEYED FOR RALPH R. & CHRISTINE B. JOSEPH  
 PROPERTY LOCATED AT NORTH HAVEN  
 MAP OF CEDARWOOD MARINE  
 FILED: OCTOBER 23, 1966; FILE NO. 5195  
 LOT NUMBER 2  
 TOWN OF BRITANNIA  
 SUFFOLK COUNTY, NEW YORK  
 AREA = 85,595 ±  
 SCALE: 1" = 60'

Plotted and shown in relation to the survey is a portion  
 of Section 22 of the Town of North Haven, Suffolk County,  
 State of New York, and bearing the Lot Surveyed. This  
 lot is situated on the east side of the road and is  
 bounded by the road on the north, east and south sides.  
 The lot is situated on the east side of the road and is  
 bounded by the road on the north, east and south sides.  
 The lot is situated on the east side of the road and is  
 bounded by the road on the north, east and south sides.

FIDELITY NATIONAL TITLE INS. CO. OF N.Y.  
 FIDELITY BANK N.Y.

*John B. [Signature]*


17270

SCALE: 1" = 60'

(CARE WIDTH)  
 S.R. 114  
 SOUTH FERRY ROAD



SURVEYED BY  
 FRANK J. BARRY, JR.  
 BRITANNIA, NEW YORK  
 NYS Lic. No. 44224  
 MARCH 24, 1967

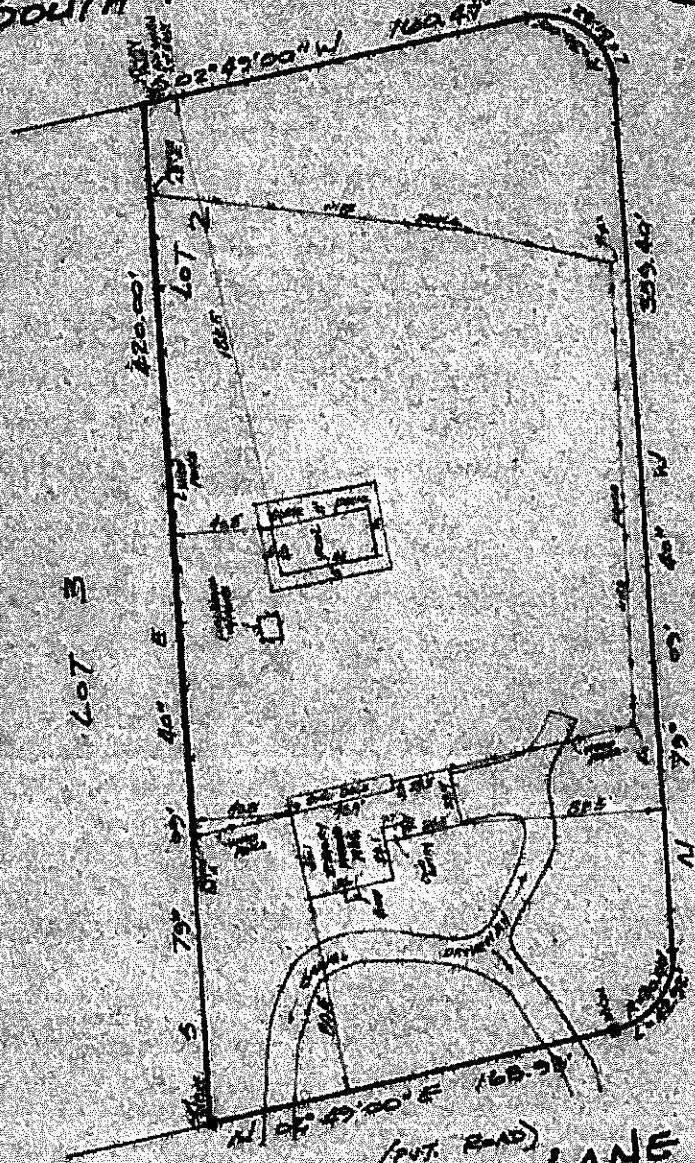

STOCK FARM LANE

UPDATE SURVEY & REESTABLISHMENT 1027-17