


DISTRICT	0900
SECTION	114.00
BLOCK	02.00
PARCEL	031.000

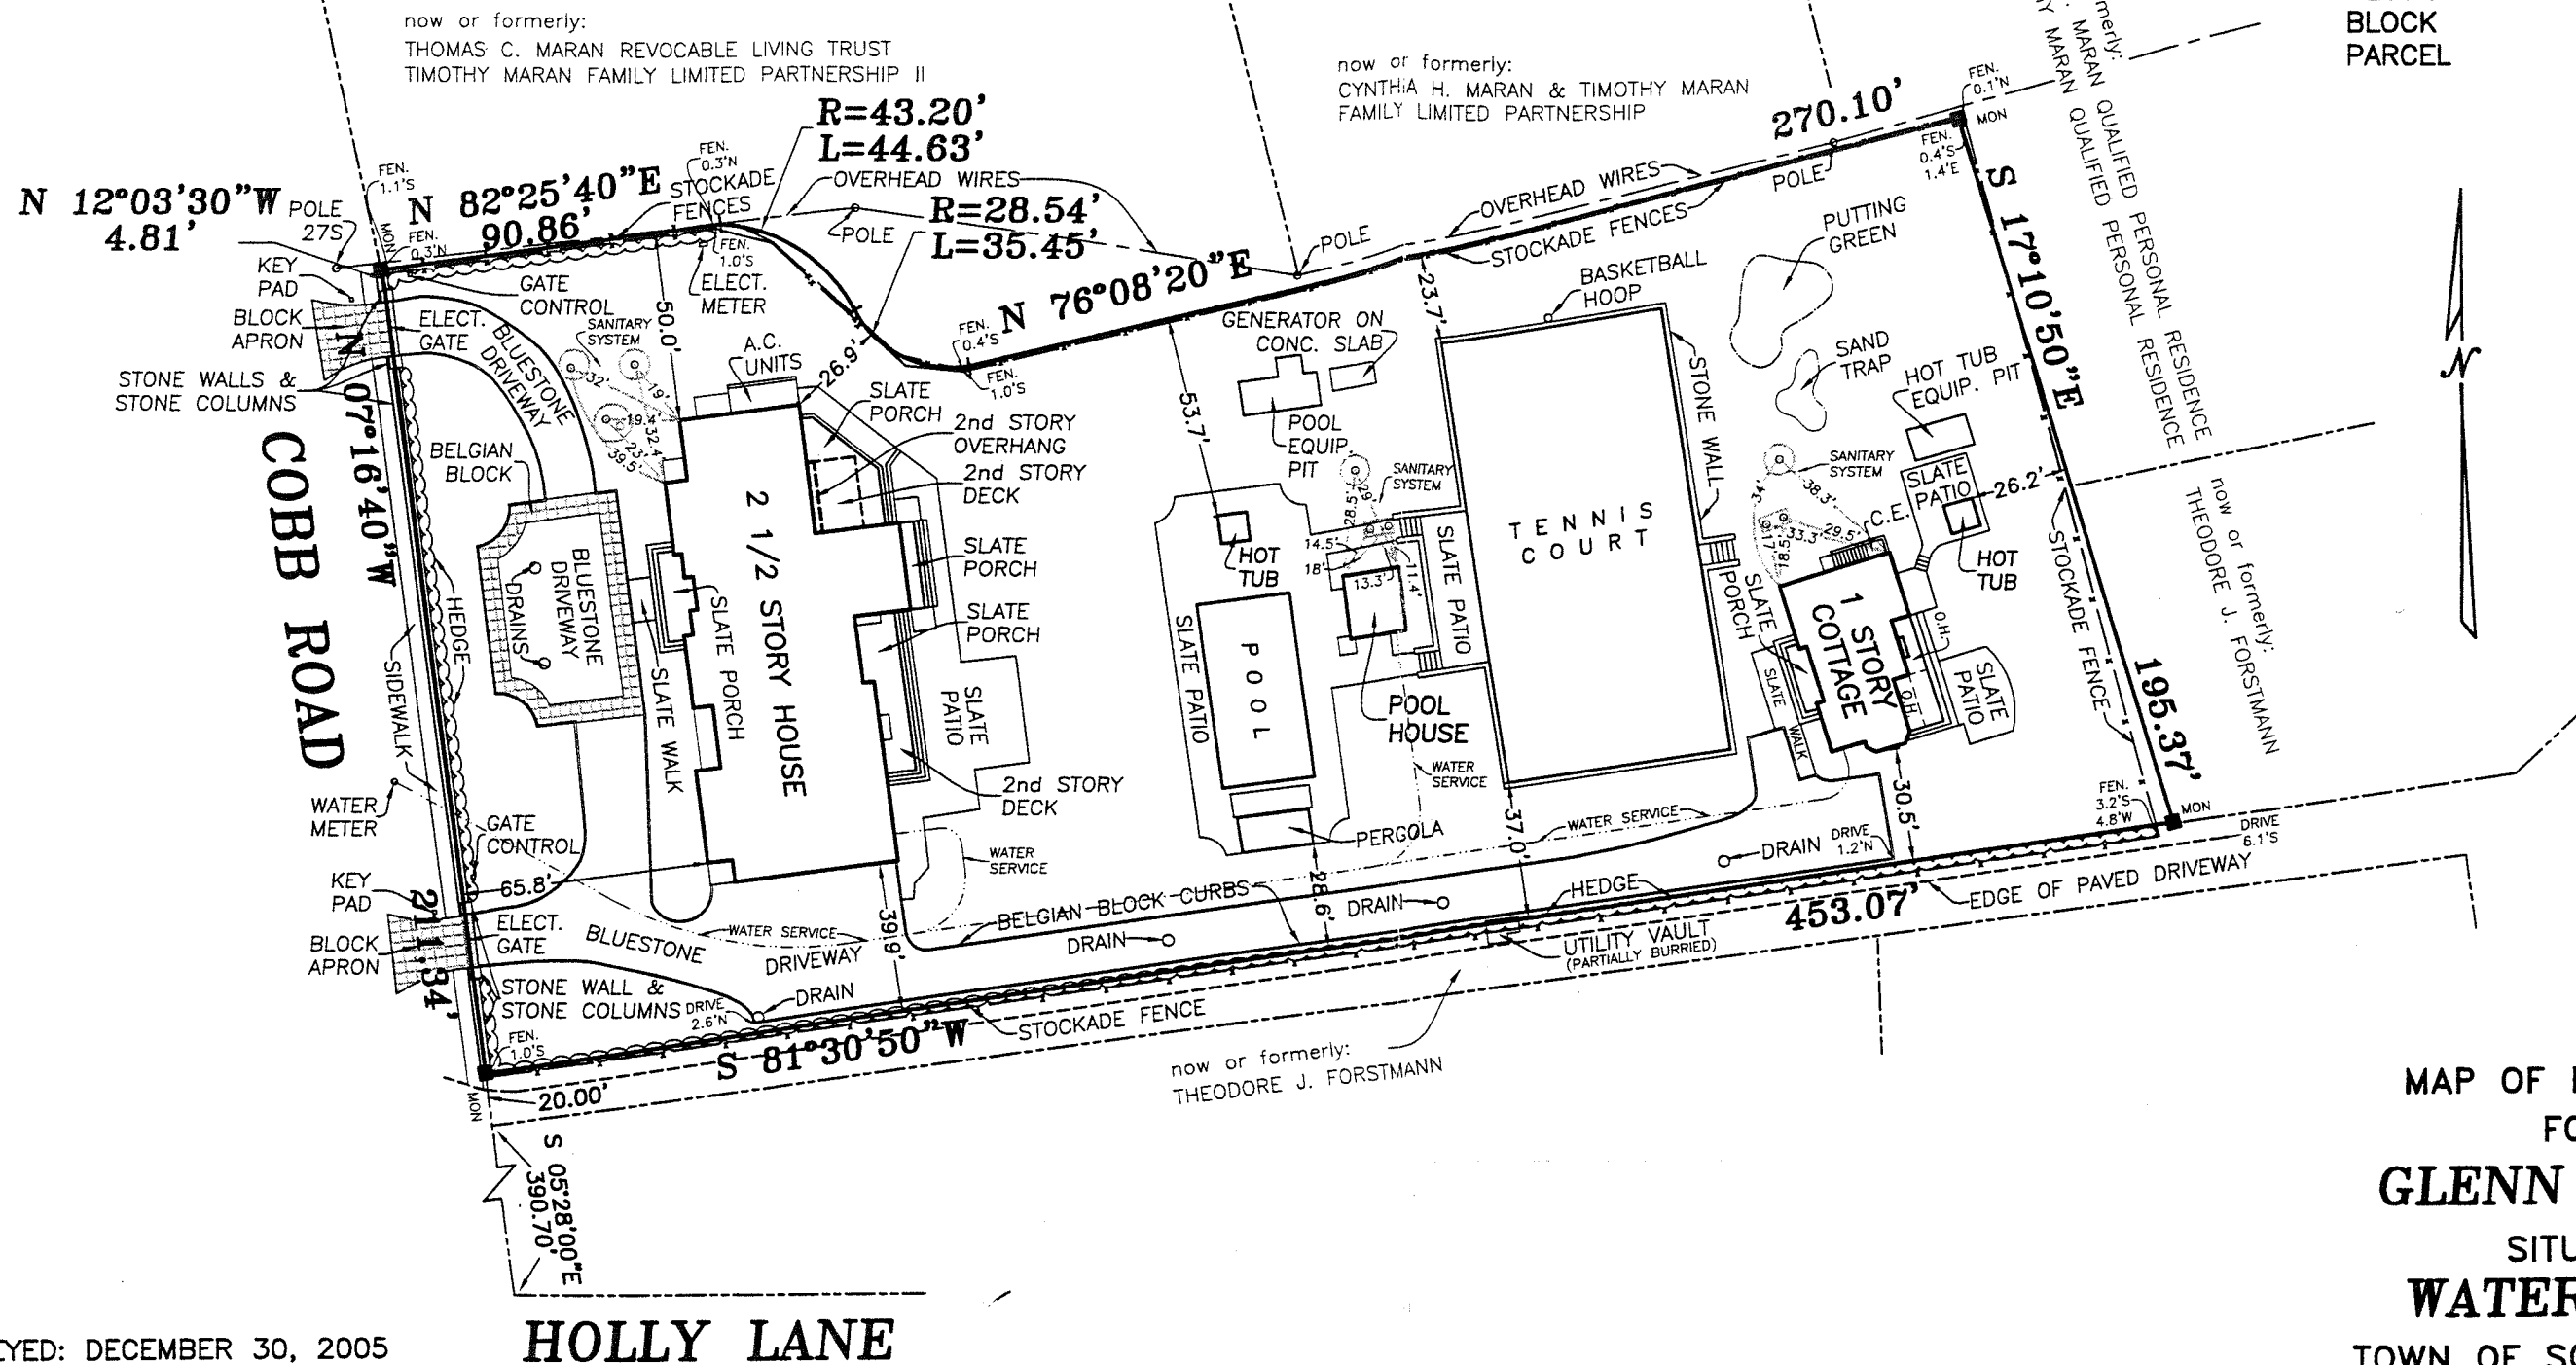

SURVEYED: DECEMBER 30, 2005

LESTER HOLDEN, L.S. 49548  
S. H. W. & S. LAND SURVEYORS P.C.

**SQUIRES, HOLDEN, WEISENBACHER & SMITH**

LAND SURVEYORS ~ ENGINEERS  
SOUTHAMPTON ~ NEW YORK

**NOTES**

1. WATER SERVICE & SANITARY SYSTEM LOCATIONS SHOWN ARE AS PER BUILDER. S.C.H.D. REF. No. R09-03-0259.

MAP OF PROPERTY  
FOR  
**GLENN SIMON**  
SITUATE  
**WATER MILL**  
TOWN OF SOUTHAMPTON  
SUFFOLK COUNTY, NEW YORK

AREA = 82,727 S.F. (1.899 AC.)

SCALE: 1" = 50'