

SURVEYED FOR:- ORAZIO & DIANE M. RENNA
LOCATED AT SPEONK

LOT 19

MAP OF HICKORY BEND

SCALE 1" = 50'

SUFFOLK CO. TAX MAP DATA:-

DIST. 0900 , SEC. 353.00

BLK. 01.00 LOT 043.023

TOWN OF SOUTHAMPTON


SUFFOLK COUNTY N.Y.

CO. CLK. NO. 9856

FILED

JUNE 27, 1996

ALEXIS LAKE

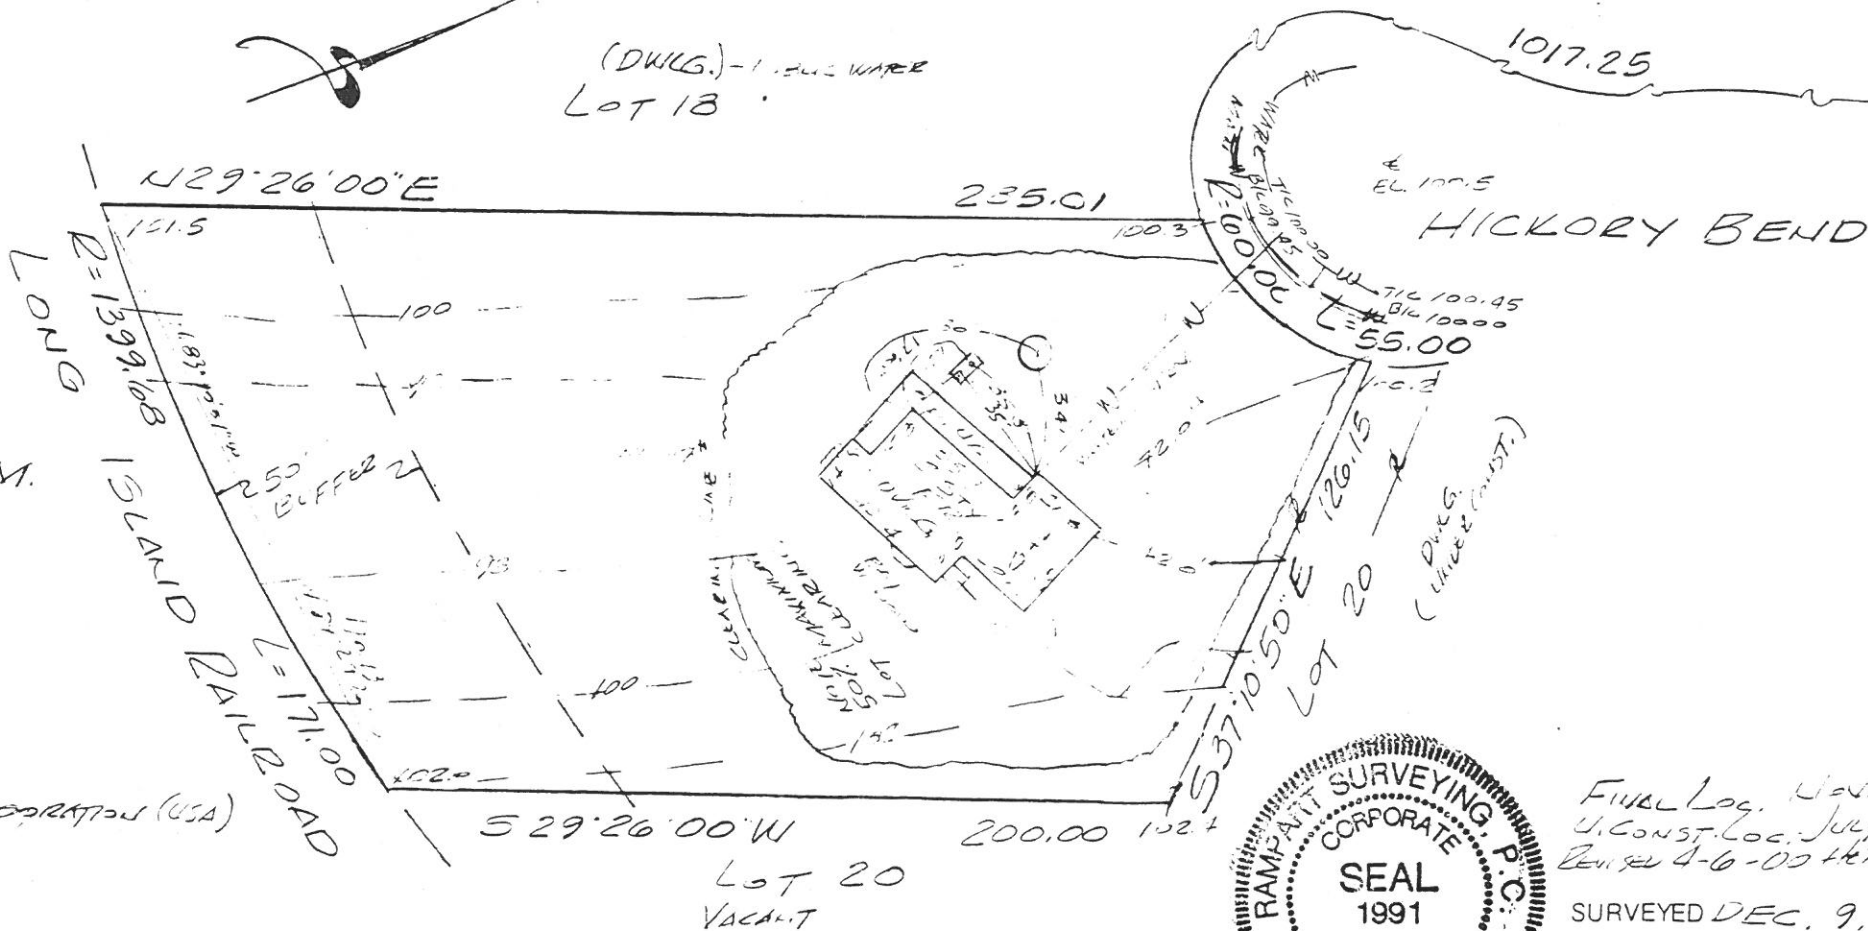

CERTIFIED TO:

ORAZIO & DIANE M.
RENNA

FIDELITY NATIONAL
TITLE INSURANCE
COMPANY

HSBC MORTGAGE CORPORATION (USA)

DRAWN BY MES

NOTE: TEST BORE REFER TO FILED MAP
UTILITIES UNDER GROUND
DISTANCE AS PER OWNERS
AN DWLG. WITHIN 15' - PUBLIC WATER



FILE NO. 14624

FINAL LOG, Nov. 6, 2000
U. CONST. LOG, July 20, 2000
REVISAL 4-6-00 H&R 2 DEPT. DATA

SURVEYED DEC. 9, 1999 BY

RAMPART SURVEYING P.C.
P/O BOX 340
EAST MORICHES, L.I., N.Y. 11940