


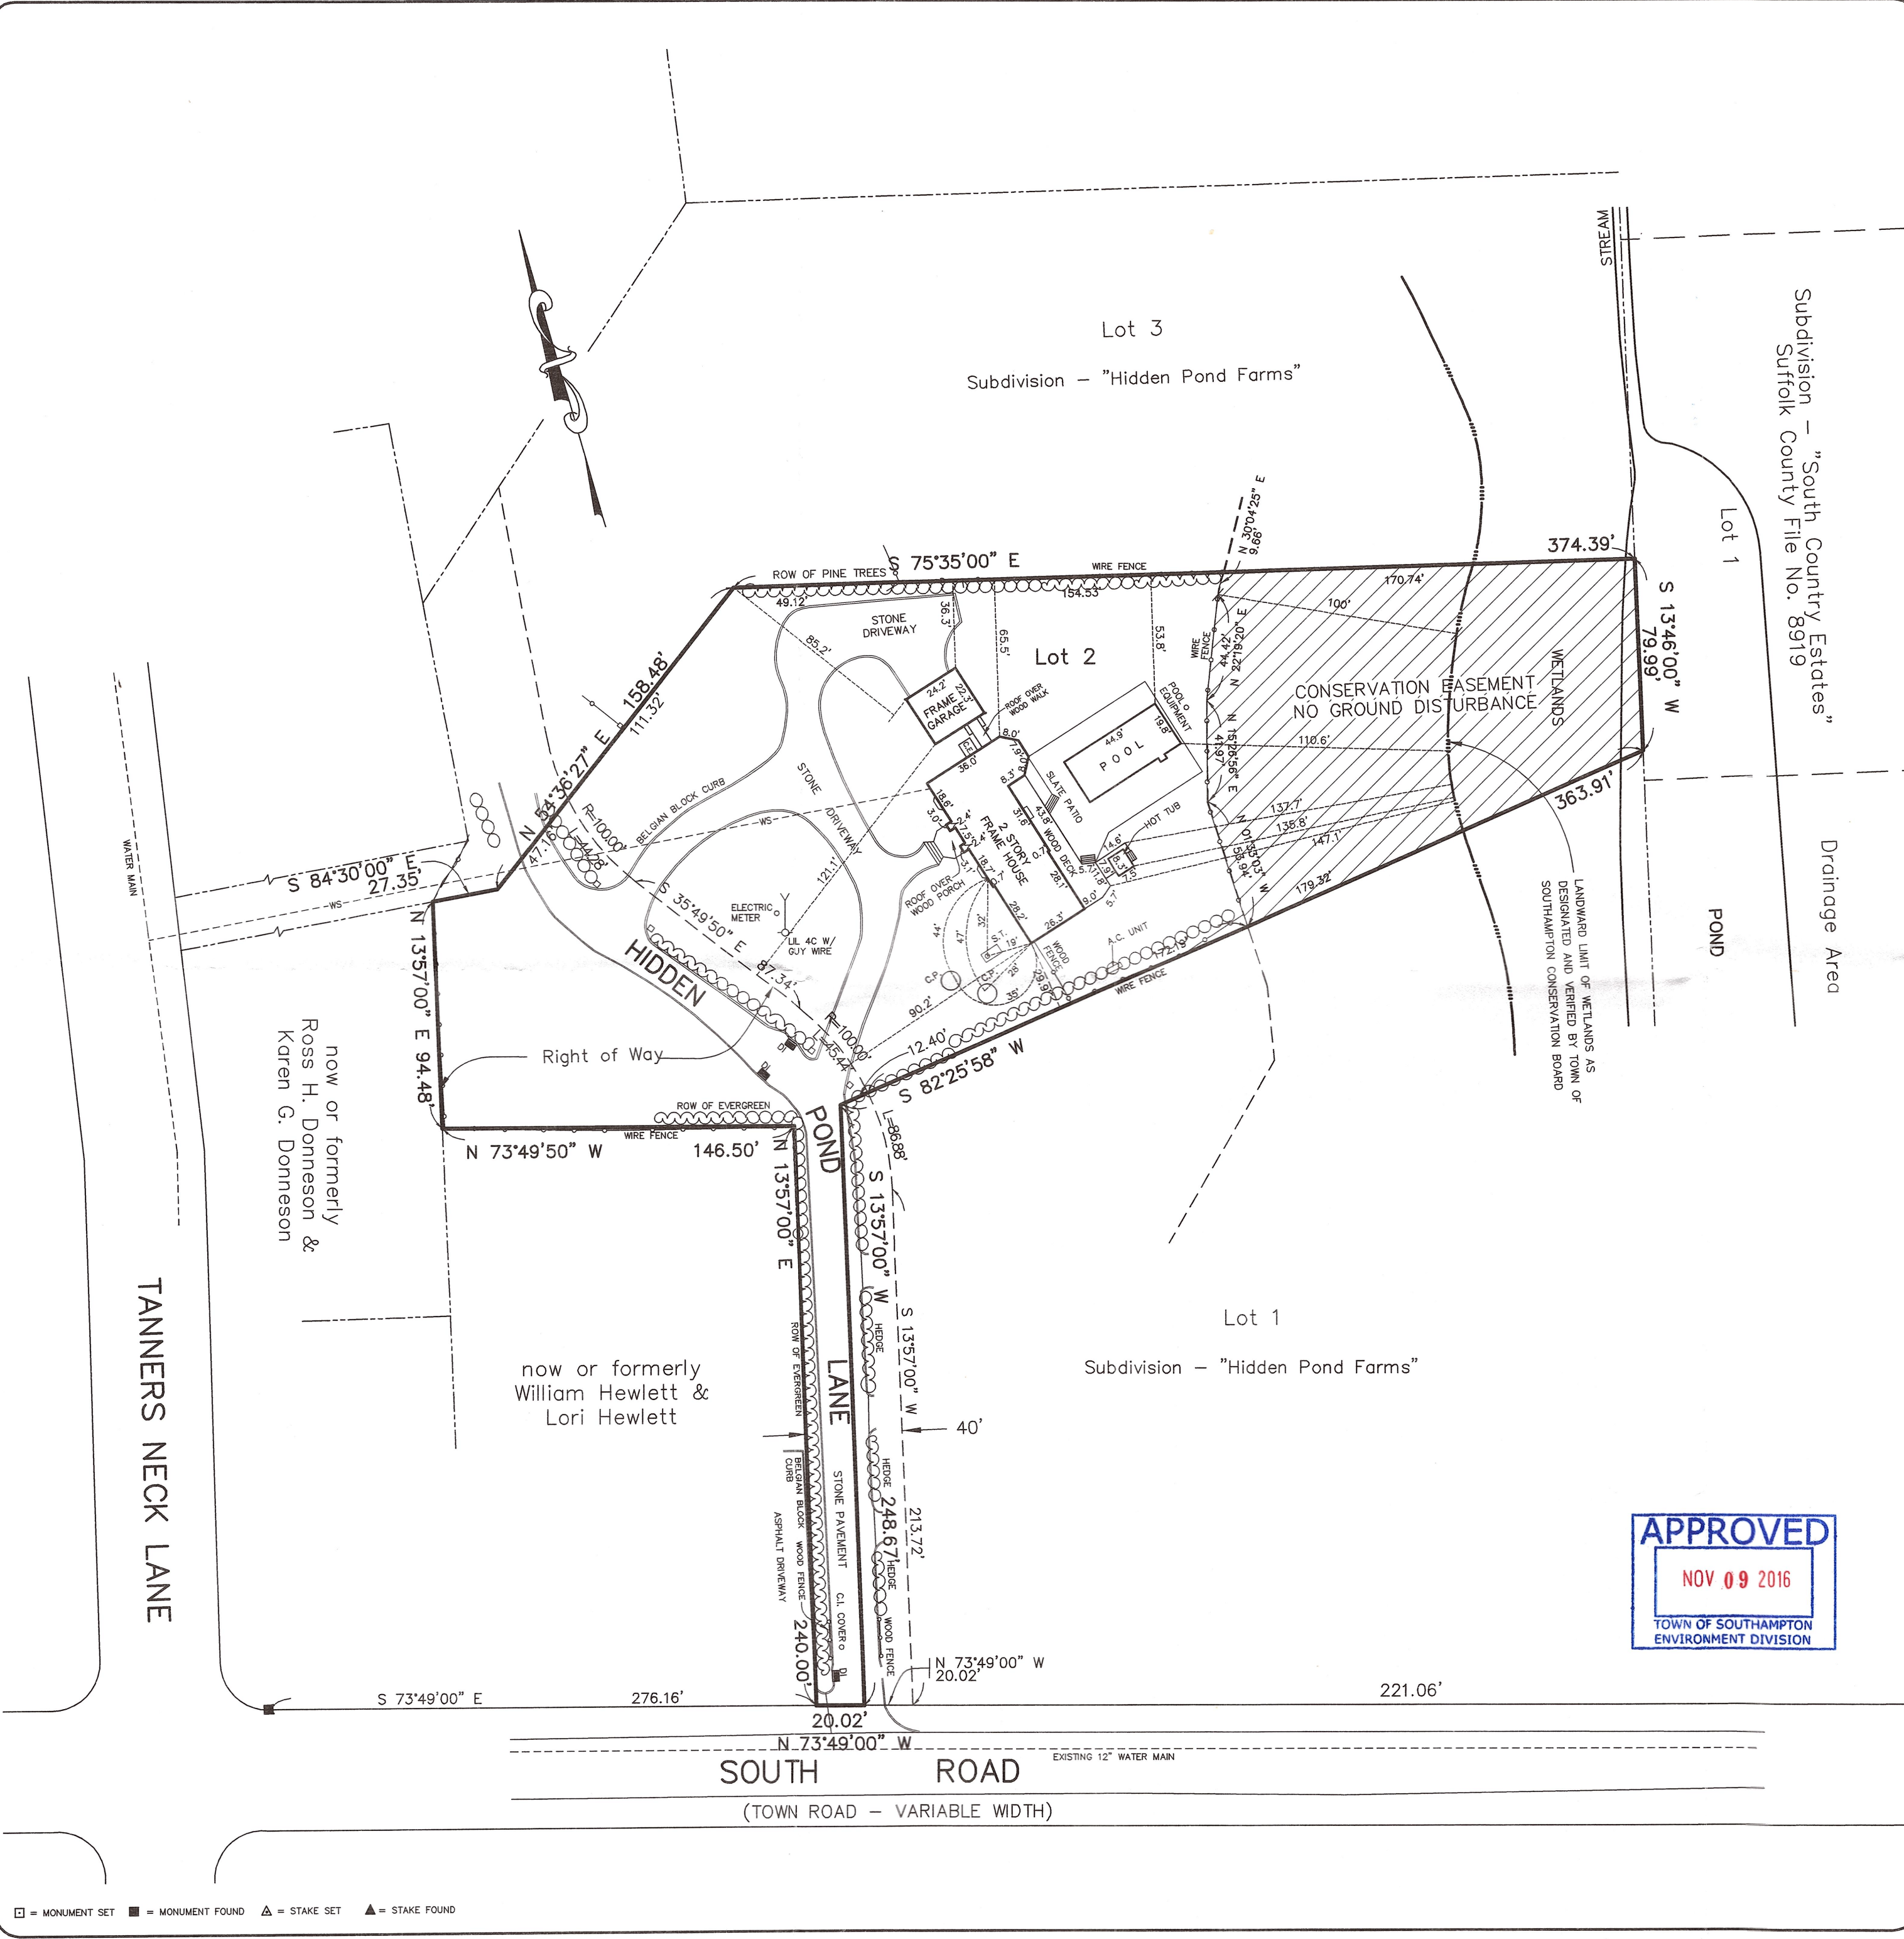

Young & Young
400 Ostrander Avenue, Riverhead, New York 11901
631-727-2303
Howard W. Young, Land Surveyor
Thomas C. Wolpert, Professional Engineer
Douglas E. Adams, Professional Engineer
Robert C. Tast, Architect

Subdivision - "Hidden Pond Farms"
Suffolk County File No. 8919

NOTE
AREA = 82,342 SQ. FT.
• SUBDIVISION MAP - "HIDDEN POND FARMS" FILED IN THE OFFICE OF THE CLERK OF SUFFOLK COUNTY ON APRIL 8, 1998 AS FILE NO. 10129.

SURVEYOR'S CERTIFICATION
• WE HEREBY CERTIFY TO **UNNI EDELMAN** THAT THIS SURVEY WAS PREPARED IN ACCORDANCE WITH THE CODE OF PRACTICE FOR LAND SURVEYS ADOPTED BY THE NEW YORK STATE ASSOCIATION OF PROFESSIONAL LAND SURVEYORS.
Howard W. Young
HOWARD W. YOUNG, N.Y.S. L.S. NO. 45893

SURVEY FOR
UNNI EDELMAN
LOT 2 "HIDDEN POND FARMS"
At Westhampton, Town of Southampton
Suffolk County, New York
County Tax Map District 900 Section 356 Block 01 Lot 8.2
BOUNDARY SURVEY

RECEIVED
OCT 06 2016
TOWN OF SOUTHAMPTON
ENVIRONMENT DIVISION
MAP PREPARED
SCALE 1" = 50'
JOB NO. 2012-0168
DWG. 2001_0401_2012_0168_bs
AUG. 27, 2012
BS

□ = MONUMENT SET ■ = MONUMENT FOUND ▲ = STAKE SET ▲ = STAKE FOUND