


75-586-CWB 431

TITLE NO. 75-S-720

NOYACK ROAD

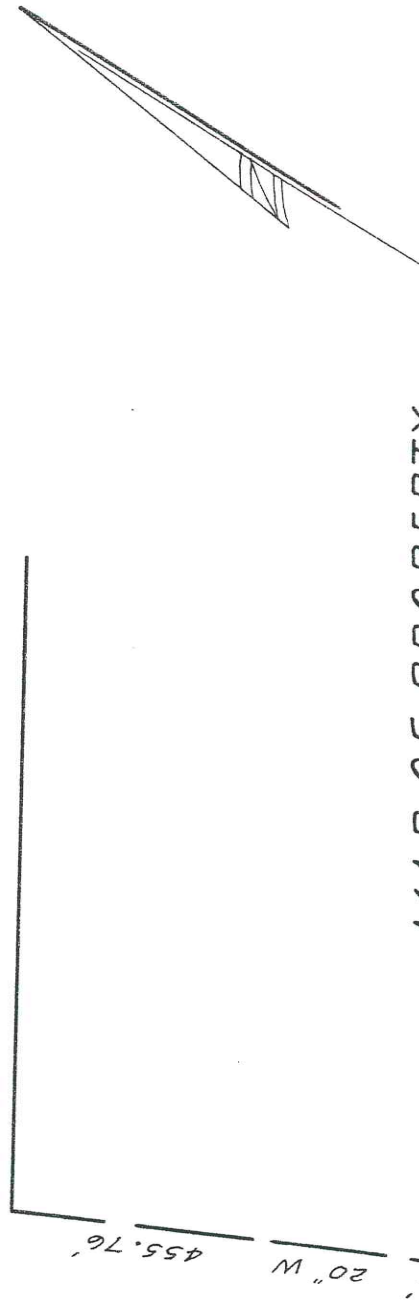


MAP OF PROPERTY
FOR
MERCURIO & ANTONINA PERNICE

SITUATE
NORTH SEA
TOWN OF SOUTHAMPTON
SUFFOLK COUNTY, N.Y.

AREA = 0.9297 AC. (40,500 SQ. FT.)

SCALE: 1" = 50'

WATER MILL ROAD - TOWND

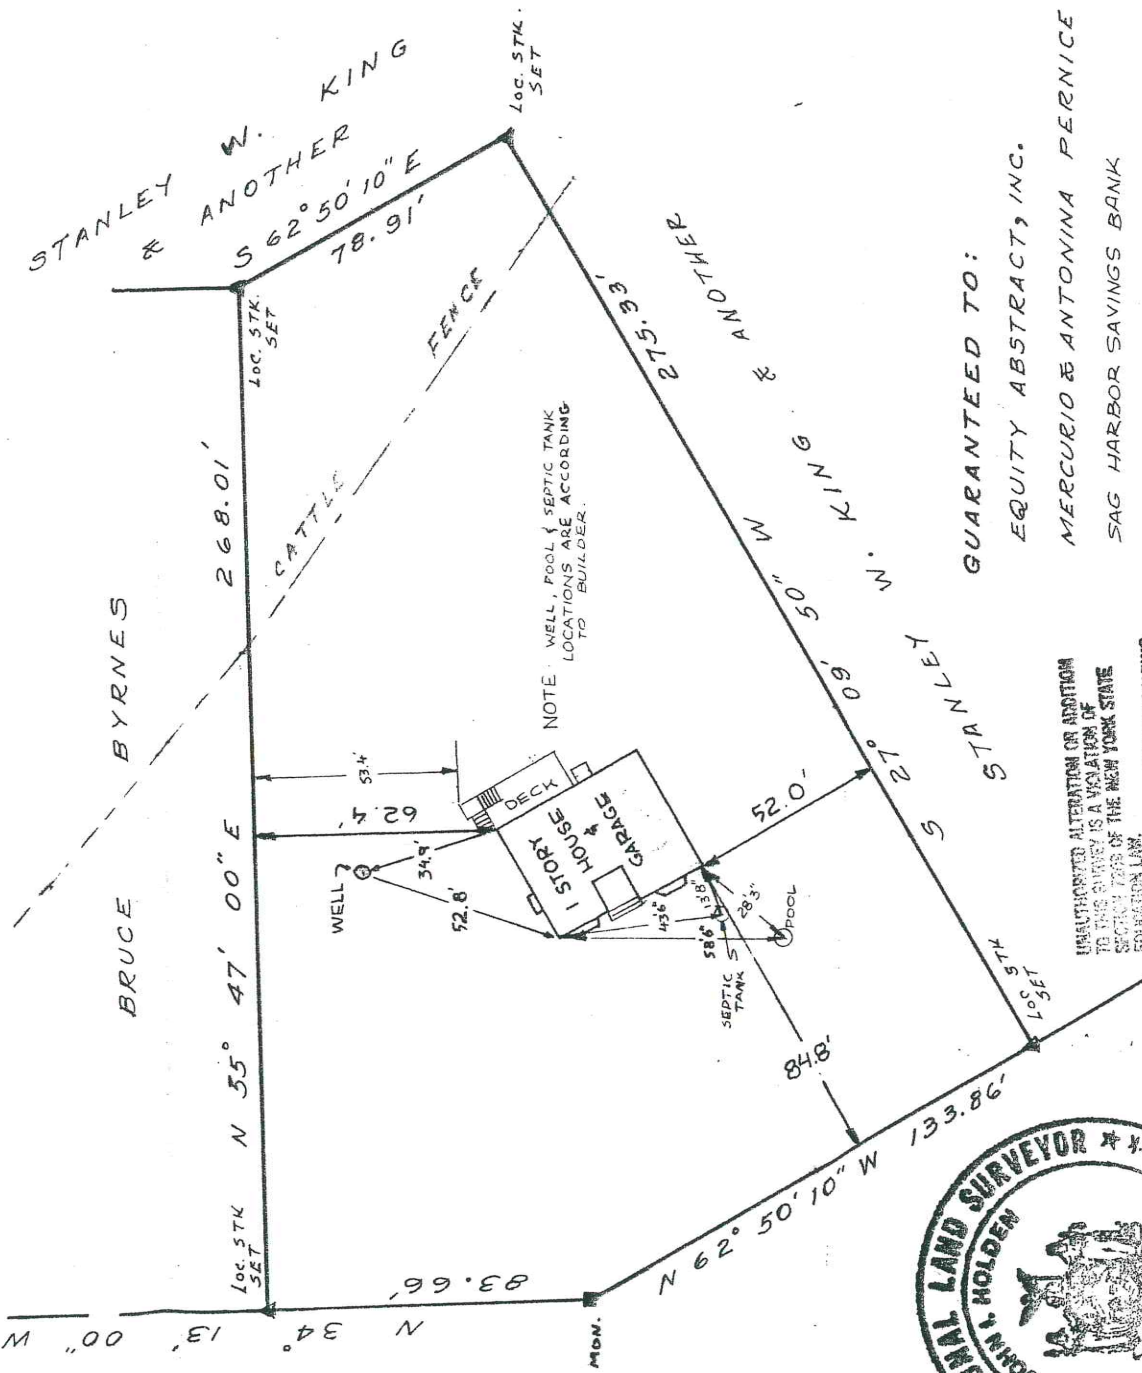

BOOK	PAGE
351	50, 51
370	141, 142

GUARANTEED TO:
EQUITY ABSTRACT, INC.
MERCURIO & ANTONINA PERNICE
SAG HARBOR SAVINGS BANK

UNAUTHORIZED ALTERATION OR ADDITION TO THIS SURVEY IS A VIOLATION OF SECTION 7209 OF THE NEW YORK STATE EDUCATION LAW.
COPY OF THIS SURVEY MAP NOT BEARING THE LAND SURVEYOR'S GREEN INKED SEAL OR SIGNATURE SHALL NOT BE CONSIDERED TO BE A VALID TRUE COPY.
I HEREBY CERTIFY THAT THE SURVEY ACCURATELY REPRESENTS THE ACTUAL AND ADJACENT REAL ESTATE AND THAT THE SAME IS TRUE AND CORRECT AS SHOWN BY THE RECORDS OF THE SURVEYING INSTRUMENTS AND RECORDS OF THE SURVEYING INSTRUMENTS.

REDATED: OCT. 13, 1978 (FINAL)
SURVEYED SEPT. 3, 1975
REDATE JULY 11, 1978 (U.C.)
REVISED: AUG. 28, 1978 - SHOW POOL - ST. & WELL, ON PL.

John I. Holden
JOHN I. HOLDEN, L.S. NO. 22118
THEODORE F. SQUIRES
L.S. NO. 14114 SURVEYOR 1542 BR