


SURVEYED FOR:-

LOCATED AT THE EAST HANCOCK SURVEY, L.I. N.Y.
LOT 11

MAP OF J. C. BARRIS LANDING, Sec. 6 (4416, 4417, 4418, 4419)
SCALE 1" = 50'

(TAX MAP: Dtg 0300, Sec. 63, AIR Co. Aug 19)

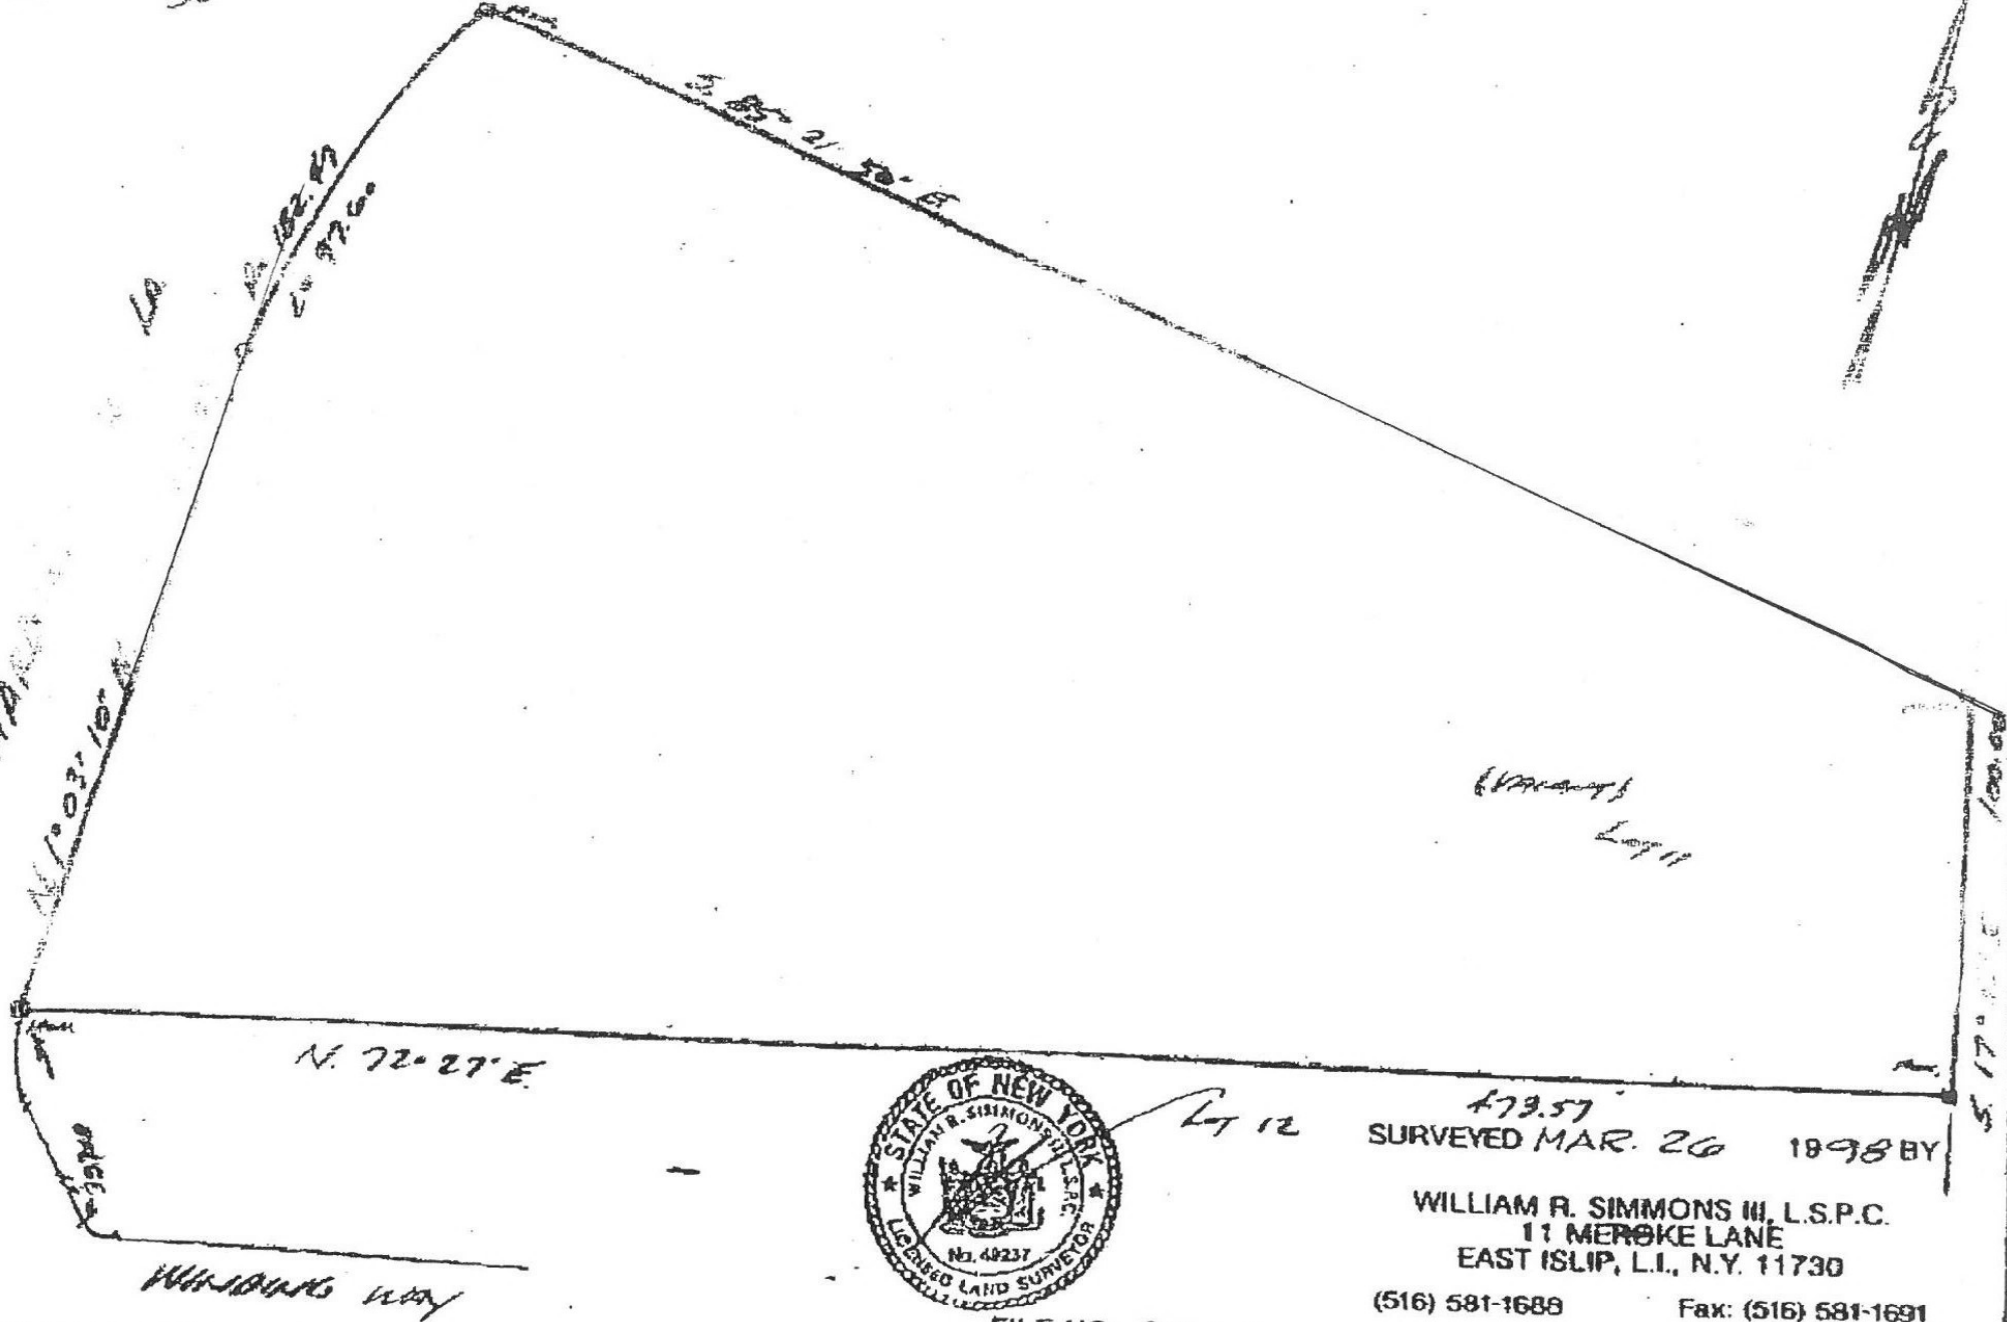

479.57
SURVEYED MAR. 26 1898 BY

WILLIAM R. SIMMONS III, L.S.P.C.
11 MEROKE LANE
EAST ISLIP, L.I., N.Y. 11730

(516) 581-1688 Fax: (516) 581-1691

PAGE GRID

DRAWN BY

FILE NO. 34.606

NASSAU SUFFOLK BLUEPRINTING 800.25.51