
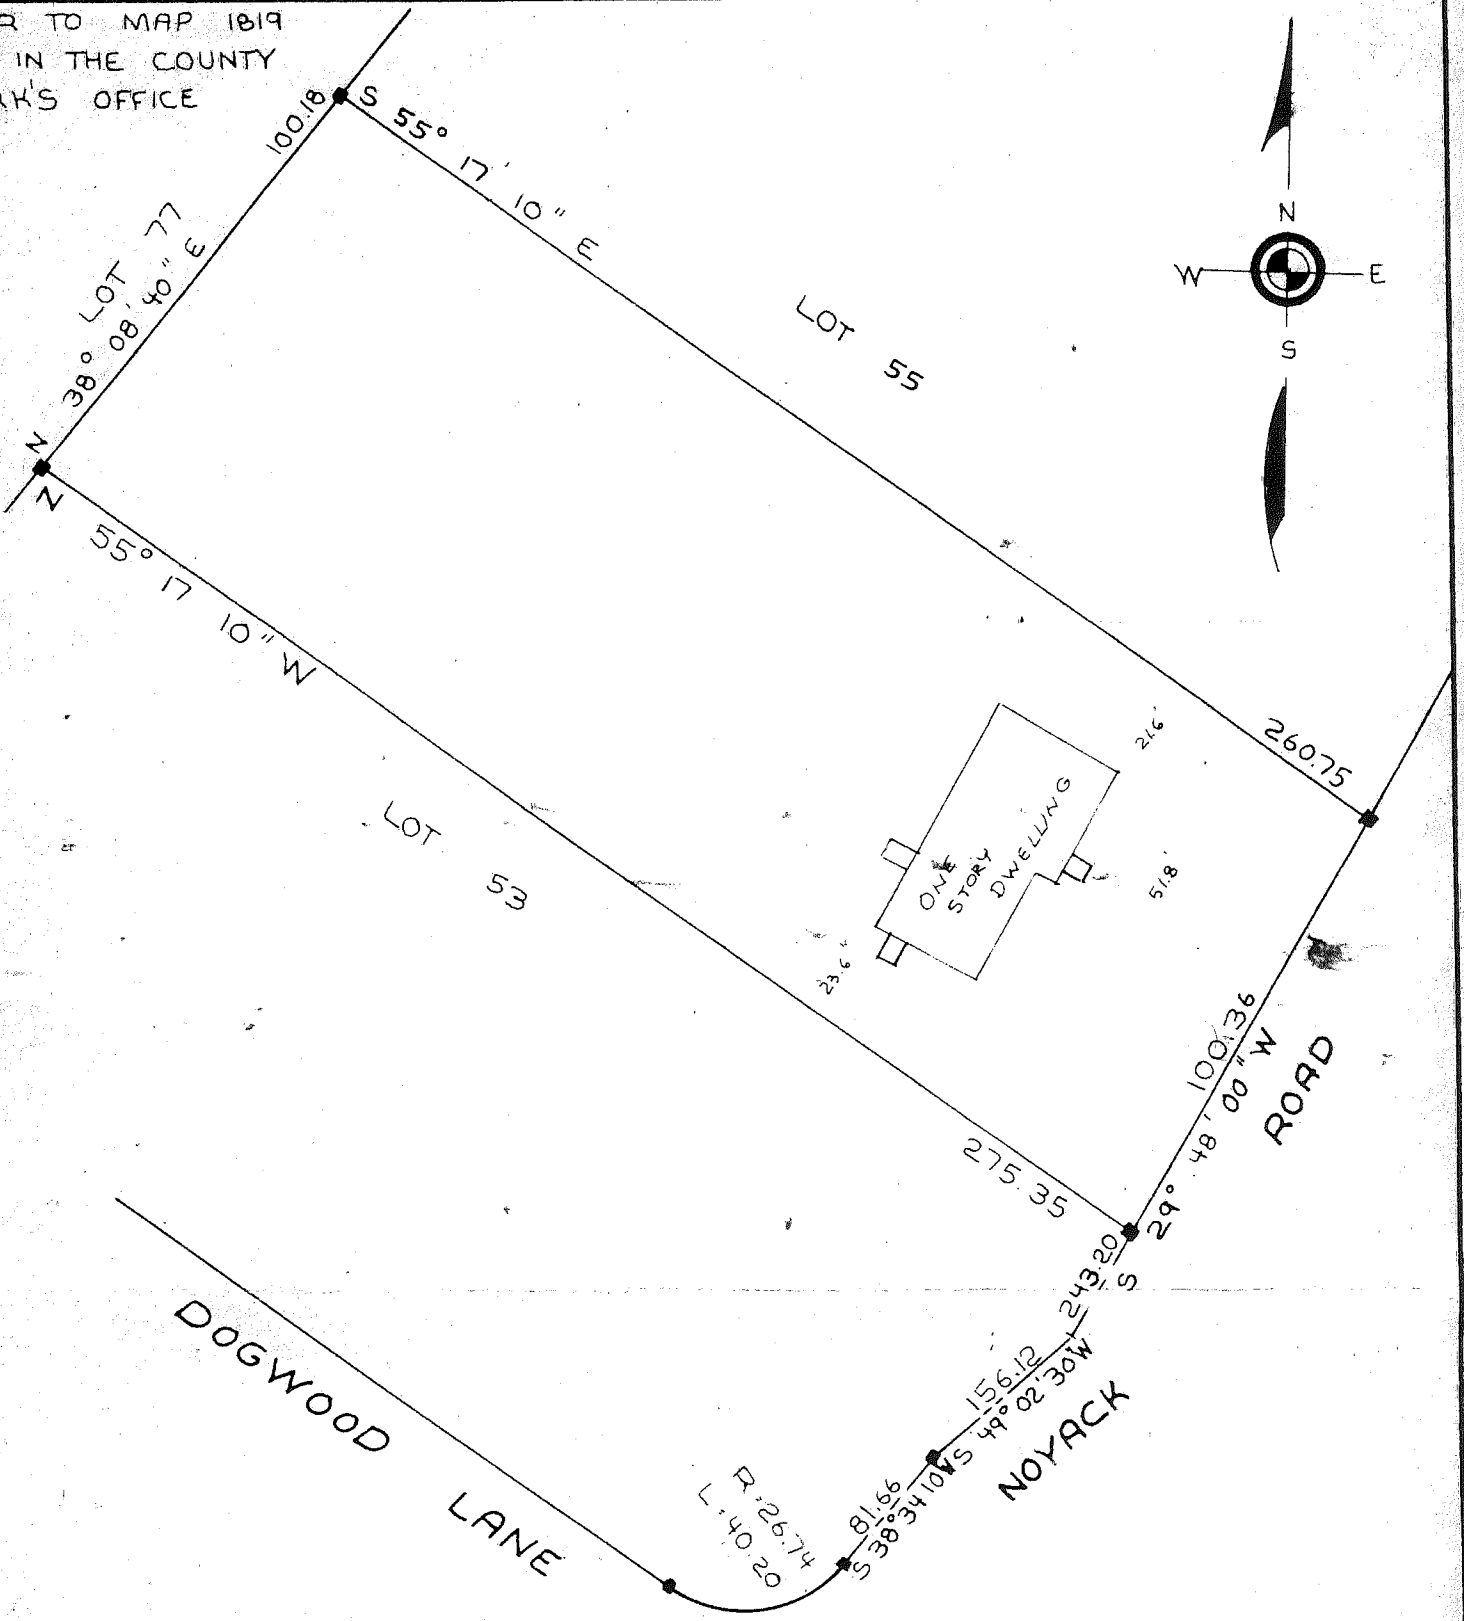


REFER TO MAP 1819  
FILED IN THE COUNTY  
CLERK'S OFFICE

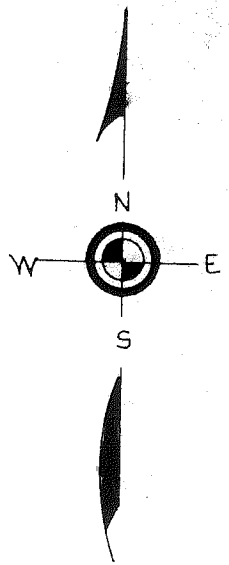

**SURVEY OF PROPERTY**

**FOR**

**ARNOLD H. + BETTY W. STOTTER**

**SITUATE**

**LOT NO. 54**

**SUNSET SHORES**

**NOYACK**

**TOWN OF SOUTHAMPTON - SUFFOLK COUNTY, N. Y.**

**GUARANTEED TO:**

**RIVERHEAD SAVINGS BANK  
SECURITY TITLE + GUARANTY CO.**

**BOOK - 61      PAGE - 06**

**SURVEYED MAY 8<sup>th</sup> 1968, REVISED JULY 15, 1968**

**CHARLES M. DOLLIVER**

**■ DENOTES CONCRETE MONUMENT**

**△ DENOTES STAKES**

**LICENSED LAND SURVEYOR # 32362**

**SCALE 1" = 40'**

**HAMPTON BAYS, L. I., N. Y.**

**DRAWN BY D.M.D. DATE 5-10<sup>th</sup> - 68**