

D 468-1A 510-96  
739-55

lots 164-169  
Map of  
Barnes Landing, Sect. 3  
Filed: June 15, 1956 Map #257E  
situate  
The Springs  
Town of East Hampton - Suffolk Co. - N.Y.  
Scale: 1" = 30'


Guaranteed to:  
Neville & Ruth Lewis  
TICOR Title Guarantee Co.,  
71284-3828



*Charles R. Kline*

Revised: June 27, 1991 - Add.  
Surveyed: November 19, 1990  
George H. Walbridge Co.  
Land Surveyors & Land Planners  
East Hampton - Long Island - N.Y.

WINDWARD 66' WIDE

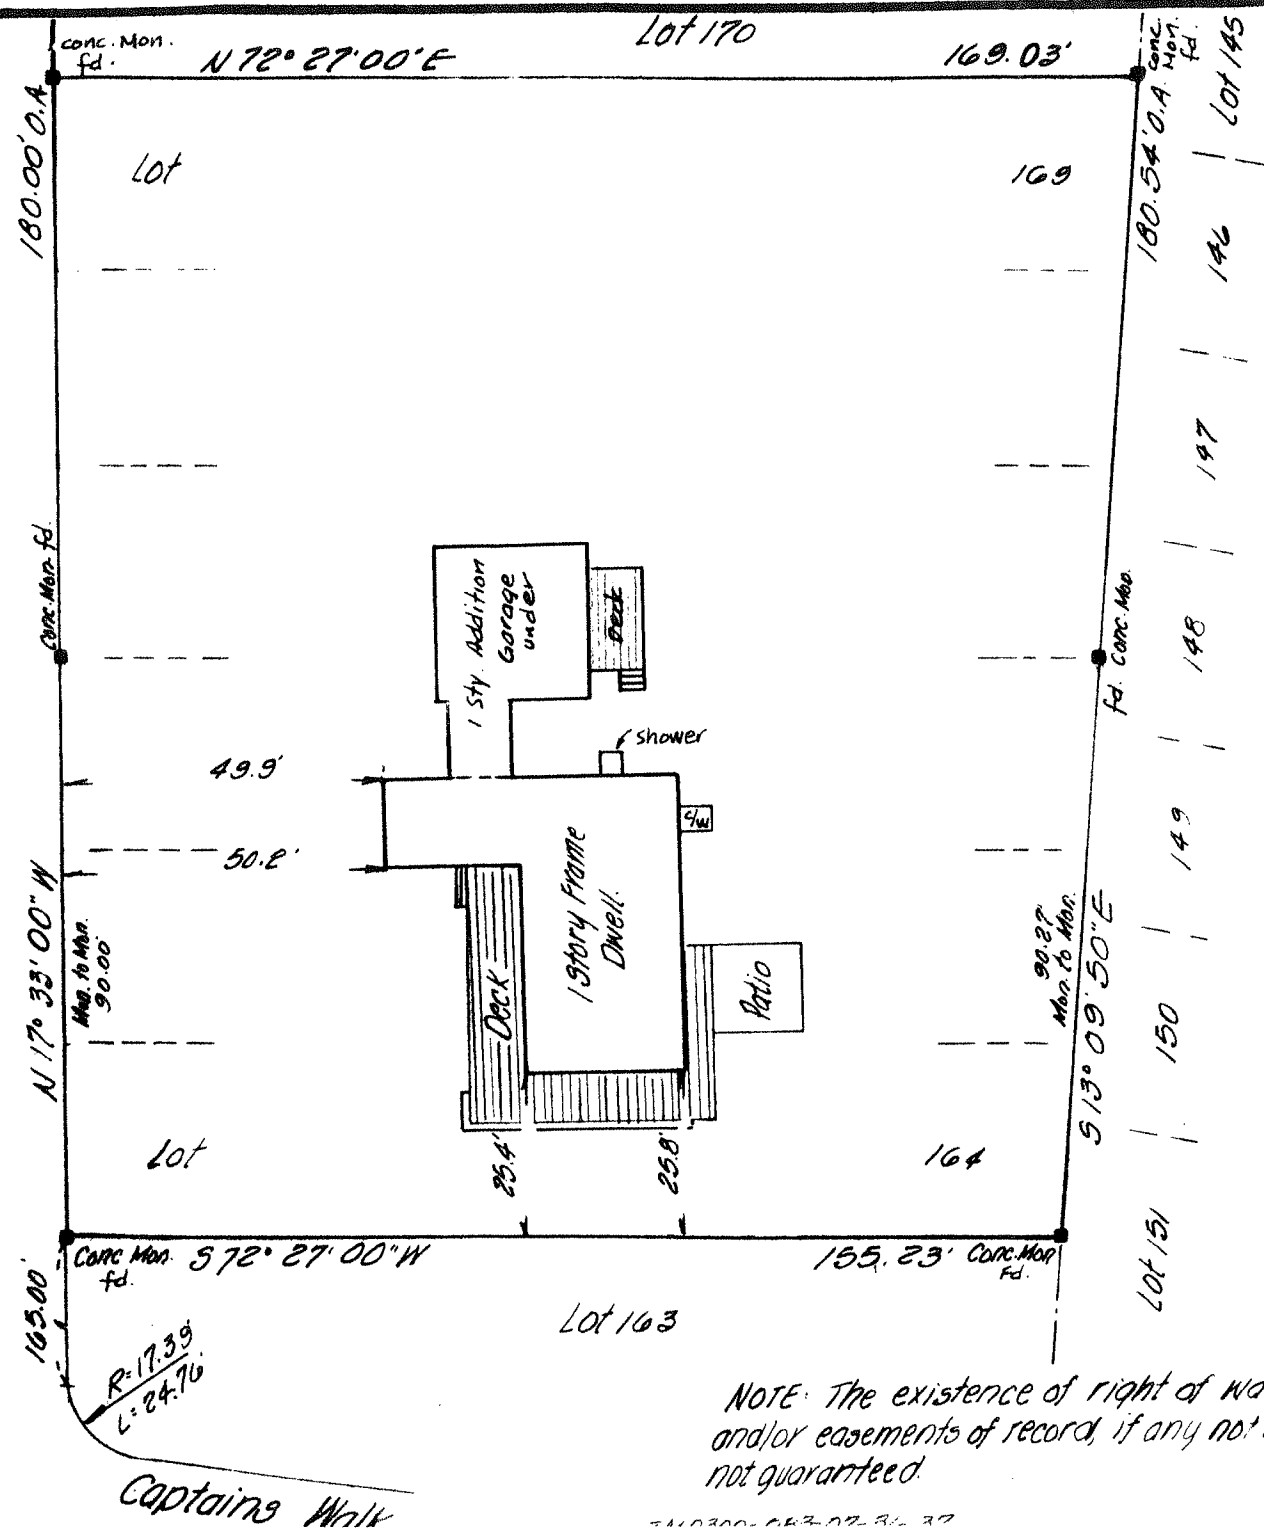

NOTE: The existence of right of ways, wetlands and/or easements of record, if any not shown are not guaranteed.

240300-067-02-31-32