


FILE NO. B-5144

TITLE NO

FROM	TO A	TO B
SEP TANK	34.2	14.6
Pool 1	36.8	27.4
Pool 2	34.3	26.1
Pool 3	21.7	21.7

SEPTIC TANK & POOL LOCATIONS

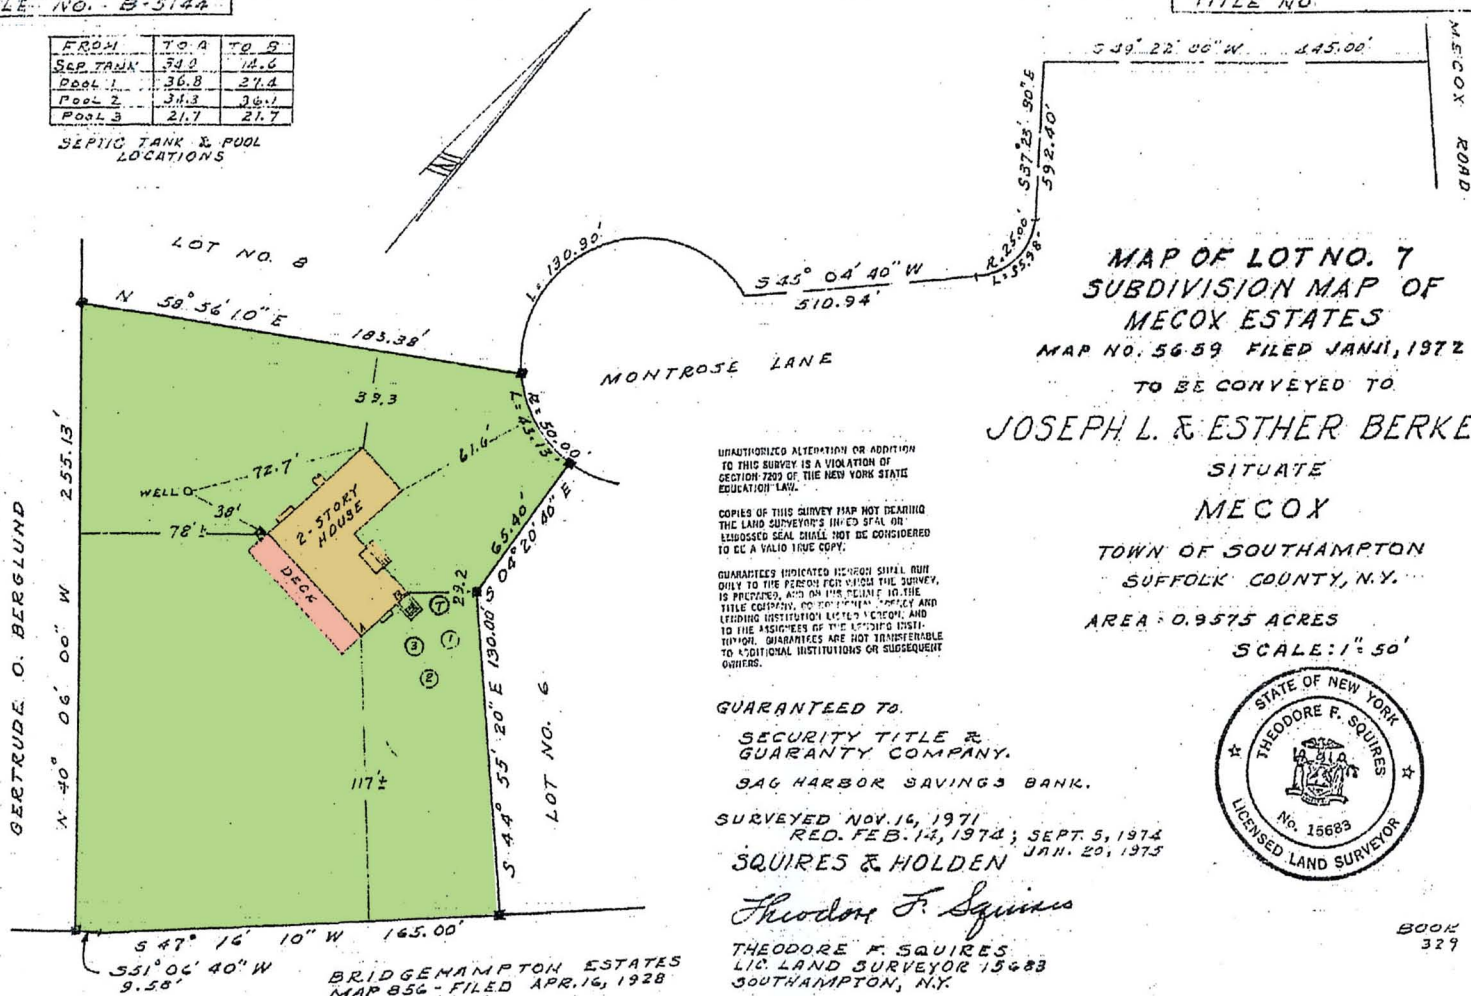

MAP OF LOT NO. 7
 SUBDIVISION MAP OF
 MECOX ESTATES
 MAP NO. 56-59 FILED JANU, 1972
 TO BE CONVEYED TO

JOSEPH L. & ESTHER BERKELEY
 SITUATE
 MECOX
 TOWN OF SOUTHAMPTON
 SUFFOLK COUNTY, N.Y.

AREA: 0.9575 ACRES
 SCALE: 1" = 50'

UNAUTHORIZED ALTERATION OR ADDITION TO THIS SURVEY IS A VIOLATION OF SECTION 7203 OF THE NEW YORK STATE EDUCATION LAW.

COPIES OF THIS SURVEY MAP NOT BEARING THE LAND SURVEYOR'S INKED SEAL OR EMBOSSED SEAL SHALL NOT BE CONSIDERED TO BE A VALID TRUE COPY.

GUARANTEES INDICATED HEREON SHALL RUN ONLY TO THE PERSON FOR WHOM THE SURVEY IS PREPARED, AND ON HIS BEHALF TO THE TITLE COMPANY, FOR THE REASON THAT THE LEADING INSTITUTION LISTED HEREON AND TO THE ASSIGNEES OF THE LEADING INSTITUTION. GUARANTEES ARE NOT TRANSFERABLE TO ADDITIONAL INSTITUTIONS OR SUBSEQUENT OWNERS.

GUARANTEED TO:
 SECURITY TITLE &
 GUARANTY COMPANY.
 346 HARBOR SAVINGS BANK.

SURVEYED NOV. 14, 1971
 RED. FEB. 14, 1974; SEPT. 5, 1974
 SQUIRES & HOLDEN JAN. 29, 1975

Theodore F. Squires
 THEODORE F. SQUIRES
 LIC. LAND SURVEYOR 15683
 SOUTHAMPTON, N.Y.



BRIDGEMAMPTON ESTATES
 MAP 856 - FILED APR. 16, 1928