


033 B3120

900-
388
022
008

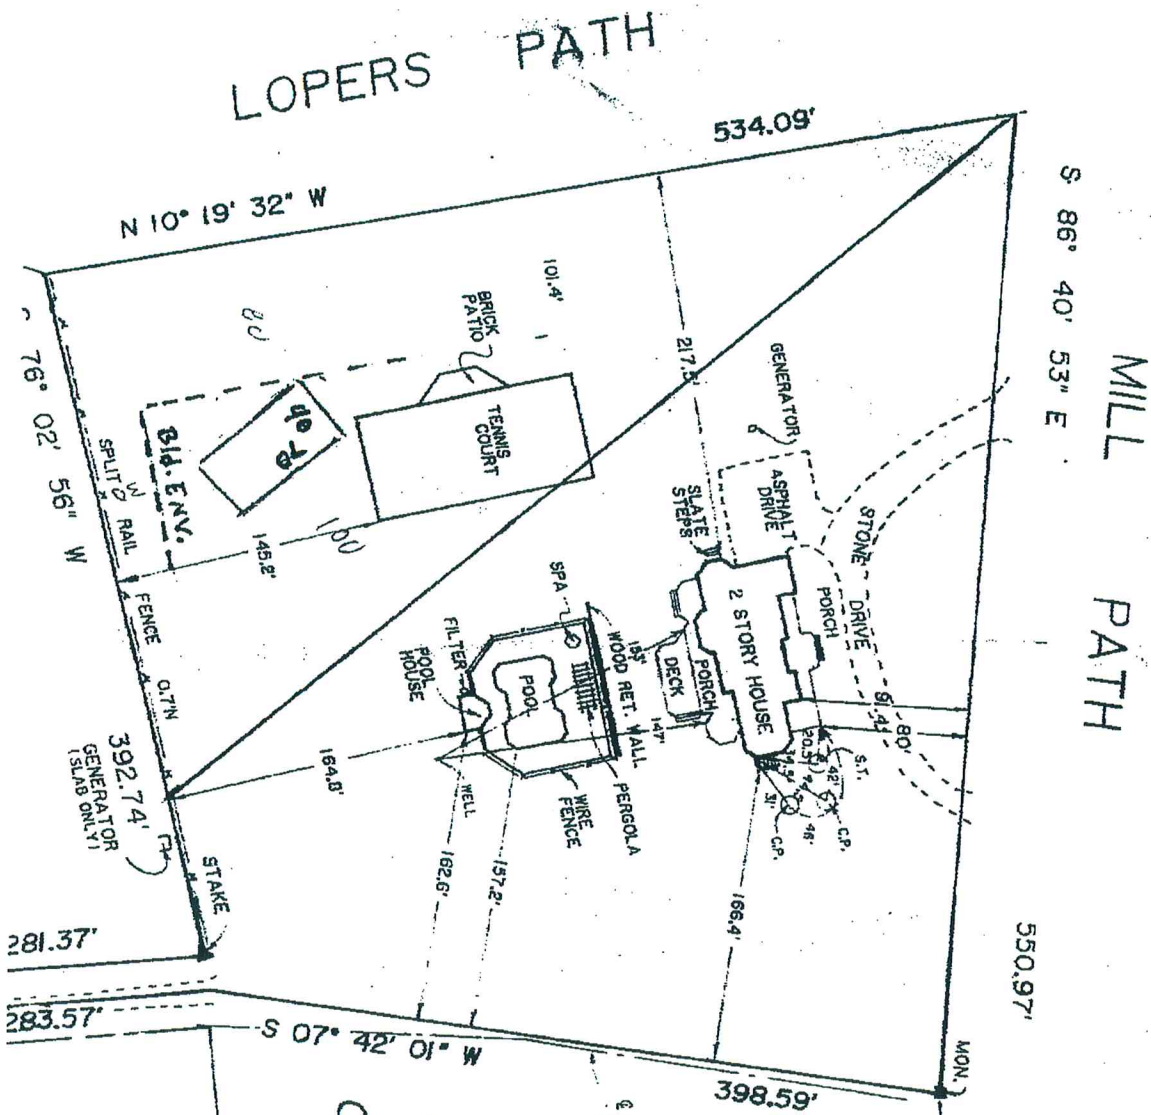

Access from Day Lilly
 Lopers OR Mill Path
 CR 80 Sat Backs

LOT 2

ROW OF PINES