


S.C.T.M. # 901-004-04-4
 AREA = 96,270 SF. = 2.2101 ACRES
 SCALE: 1"=60'

HERON WAY
 (REN COURT)

RED COATS LA
 (ROSE LANE)

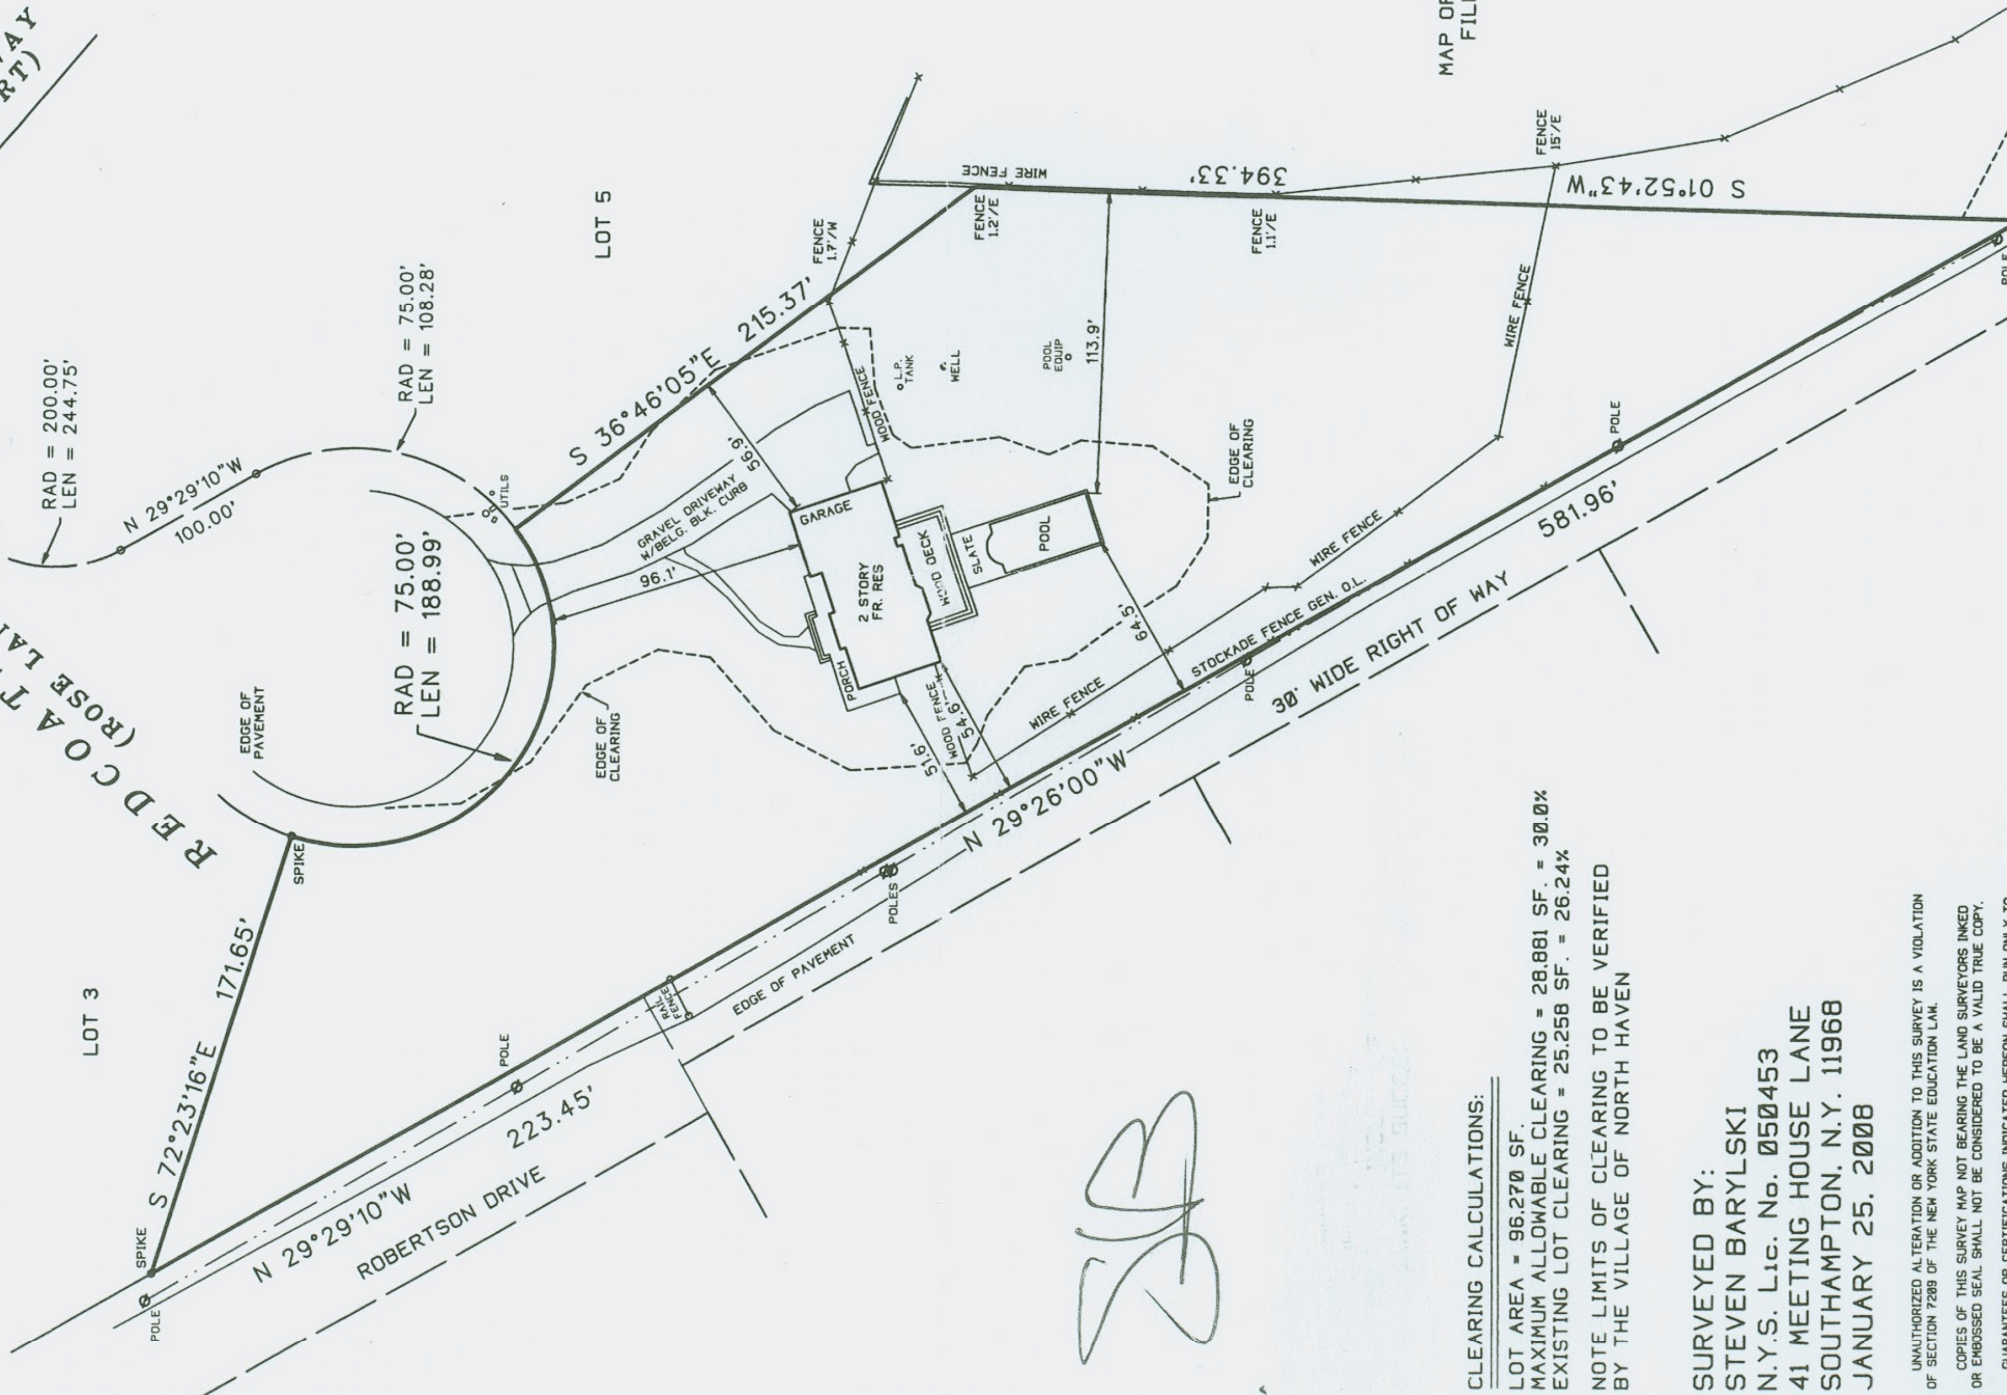

Handwritten signature

CLEARING CALCULATIONS:
 LOT AREA = 96,270 SF.
 MAXIMUM ALLOWABLE CLEARING = 28,881 SF. = 30.0%
 EXISTING LOT CLEARING = 25,258 SF. = 26.24%
 NOTE LIMITS OF CLEARING TO BE VERIFIED
 BY THE VILLAGE OF NORTH HAVEN

SURVEYED BY:
 STEVEN BARYLSKI
 N.Y.S. Lic. No. 050453
 41 MEETING HOUSE LANE
 SOUTHAMPTON, N.Y. 11968
 JANUARY 25, 2008

UNAUTHORIZED ALTERATION OR ADDITION TO THIS SURVEY IS A VIOLATION
 OF SECTION 7289 OF THE NEW YORK STATE EDUCATION LAW.
 COPIES OF THIS SURVEY MAP NOT BEARING THE LAND SURVEYORS INKED
 OR EMBOSSED SEAL SHALL NOT BE CONSIDERED TO BE A VALID TRUE COPY.
 GUARANTEES OR CERTIFICATIONS INDICATED HEREON SHALL BE VALID ONLY IF