



FIRST FLOOR PLAN SCALE 3/32" = 1'-0" TOTAL BUILDING AREA = 2,124 SQ.FT. EXISTING DECK AREA = 502 SQ.FT.

ROSEBERRY
ARCHITECTURAL
STUDIO
JOHN D. (JACK) ROSEBERRY, AIA
1029 SIPP AVENUE
MEDFORD, N.Y. 11763
PHONE: (631) 730-1262
FAX: (631) 730-5476
E-MAIL: roseberry@optonline.net

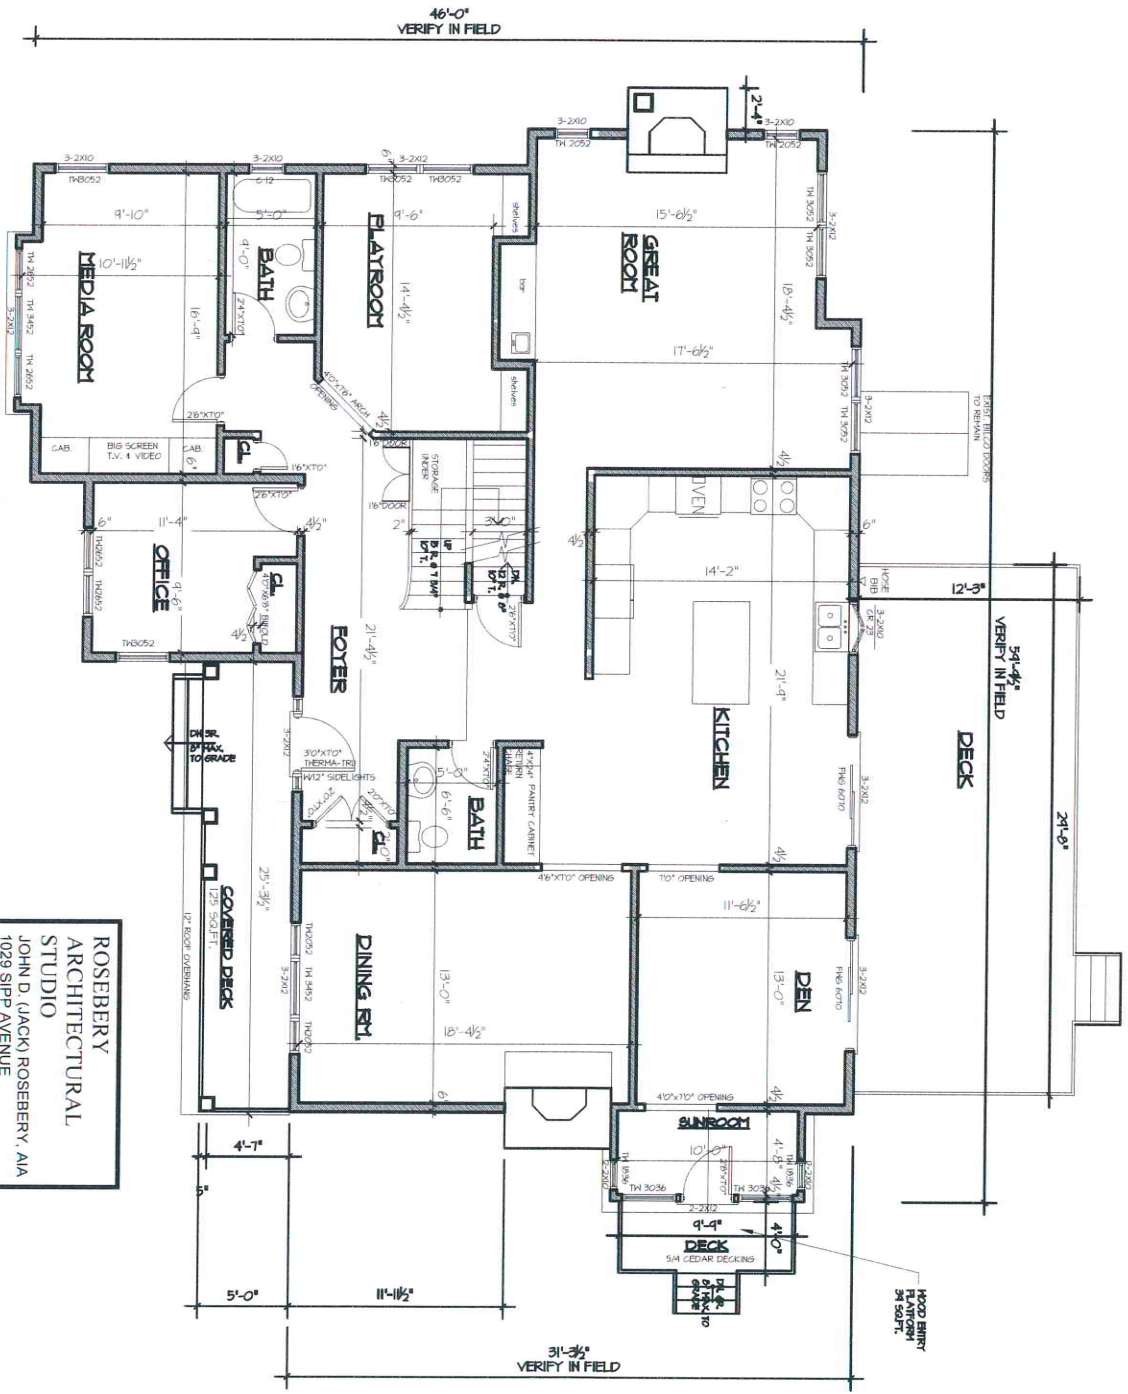

ROSEBERY
ARCHITECTURAL
STUDIO
JOHN D. (JACK) ROSEBERY, AIA
1029 SIPP AVENUE
MEDFORD, N.Y. 11763
PHONE: (631) 730-1262
FAX: (631) 730-5476
E-MAIL: rosebery@optonline.net

DISTRICT 0904
SECTION 20.00
BLOCK 02.00
PARCEL 031.000

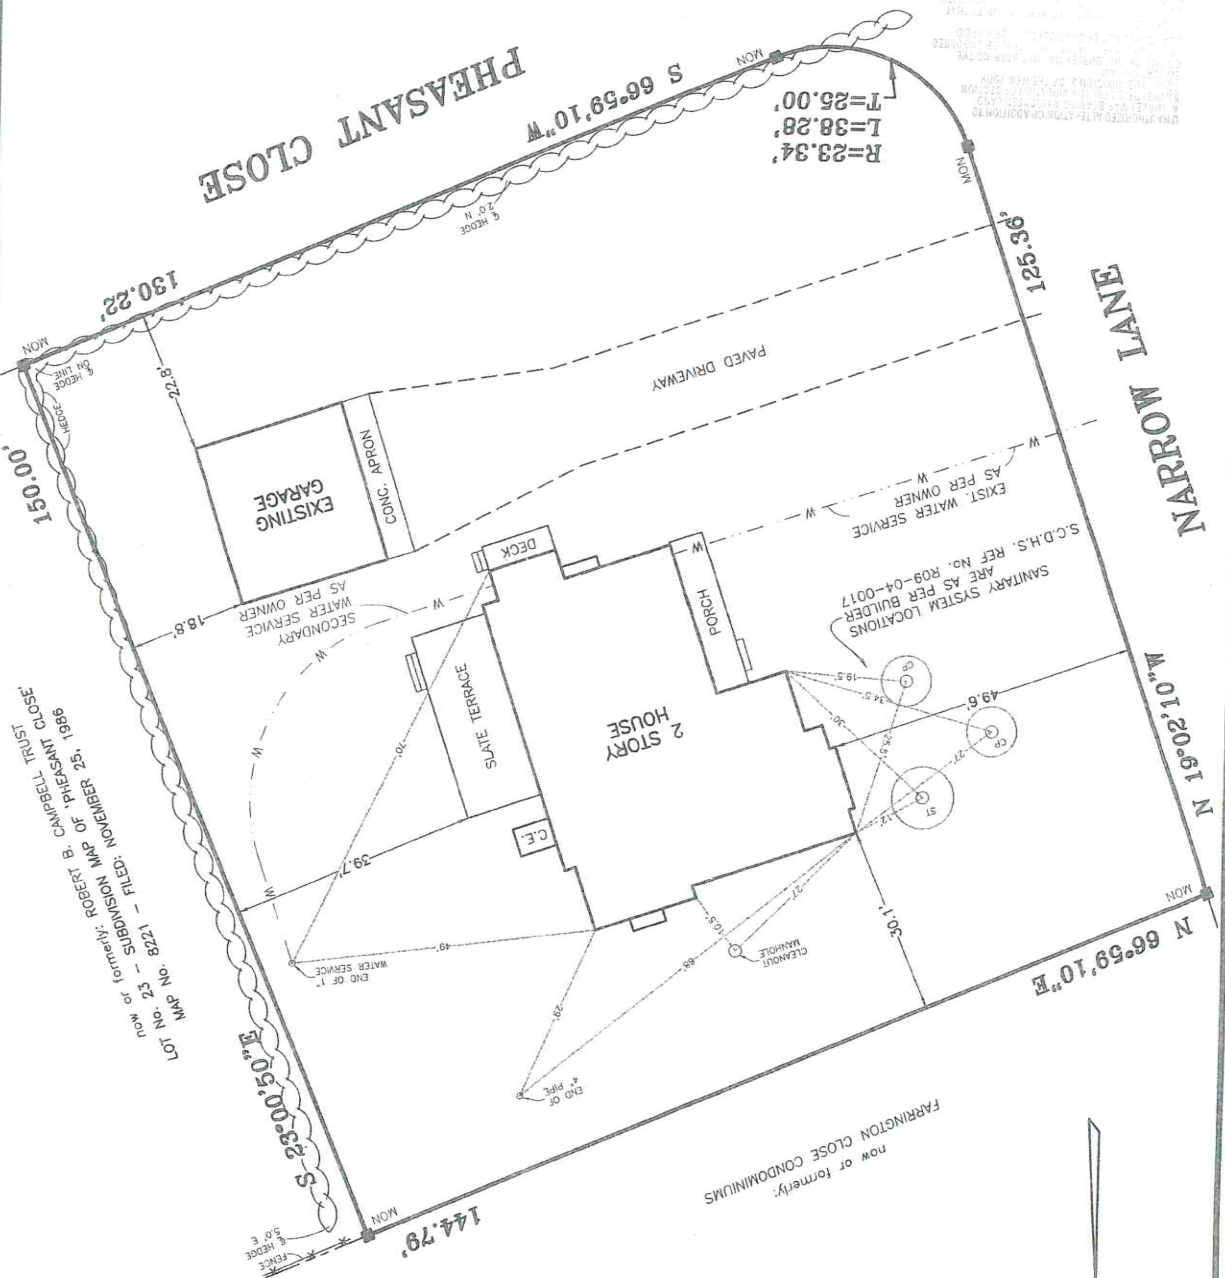

REVISID: JULY 28, 2006 (FINAL)
SURREYED: MAY 26, 2002
KARL W. WEISENBACHER, L.S. No. 36195
S. H. W. & S. LAND SURVEYORS P.C.
SQUIRES, HOLDEN, WEISENBACHER & SMITH
LAND SURVEYORS ~ ENGINEERS
SOUTHAMPTON ~ NEW YORK
SCALE: 1" = 20'
AREA = 22,014 S.F. (0.505 ACRES)

MAP OF PROPERTY
FOR
SOUTHAMPTON REALTY LLC
SITUATE
INC. VILLAGE OF SOUTHAMPTON
TOWN OF SOUTHAMPTON
SUFFOLK COUNTY, NEW YORK

Pace Residence

50 Narrow Lane
Incorporated Village of Southampton
Town of Southampton
Suffolk County, New York
November 7, 2009

Landscape Design Plan
Daniel Stiggenwald
Designer

NOTES:



Scale: 1/8" = 1'

Optional Pool/Landscape Plan

NARROW LANE

