
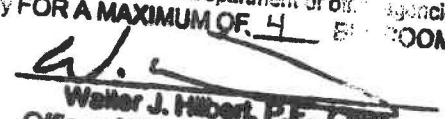


**MAP OF LOT 4**  
**BLOCK 130**  
**SUBDIVISION 11**  
 MONTAUK BEACH DEVELOPMENT CORP.  
 SITUATE  
**MONTAUK, TOWN**  
**OF EAST HAMPTON**  
 SUFFOLK CO., N.Y.  
 FILED MAY 6, 1927 AS MAP 1021  
 SCALE 1" = 30'  
 TAX MAP REF: 300-32-02-15  
 DATUM: NAVD88

**SUFFOLK COUNTY DEPARTMENT OF HEALTH SERVICES**  
**APPROVAL OF CONSTRUCTED WORKS FOR**  
**A SINGLE FAMILY RESIDENCE**  
 Date DEC 02 2014 H.S. Ref. No. R03-13-0010  
 The sewer, electrical and water supply facilities location have been inspected and/or certified by this Department or other agencies and found to be satisfactory FOR A MAXIMUM OF 4 BATHROOMS.  
  
 Walter J. Hilbert, P.E., Chief  
 Office of Wastewater Management

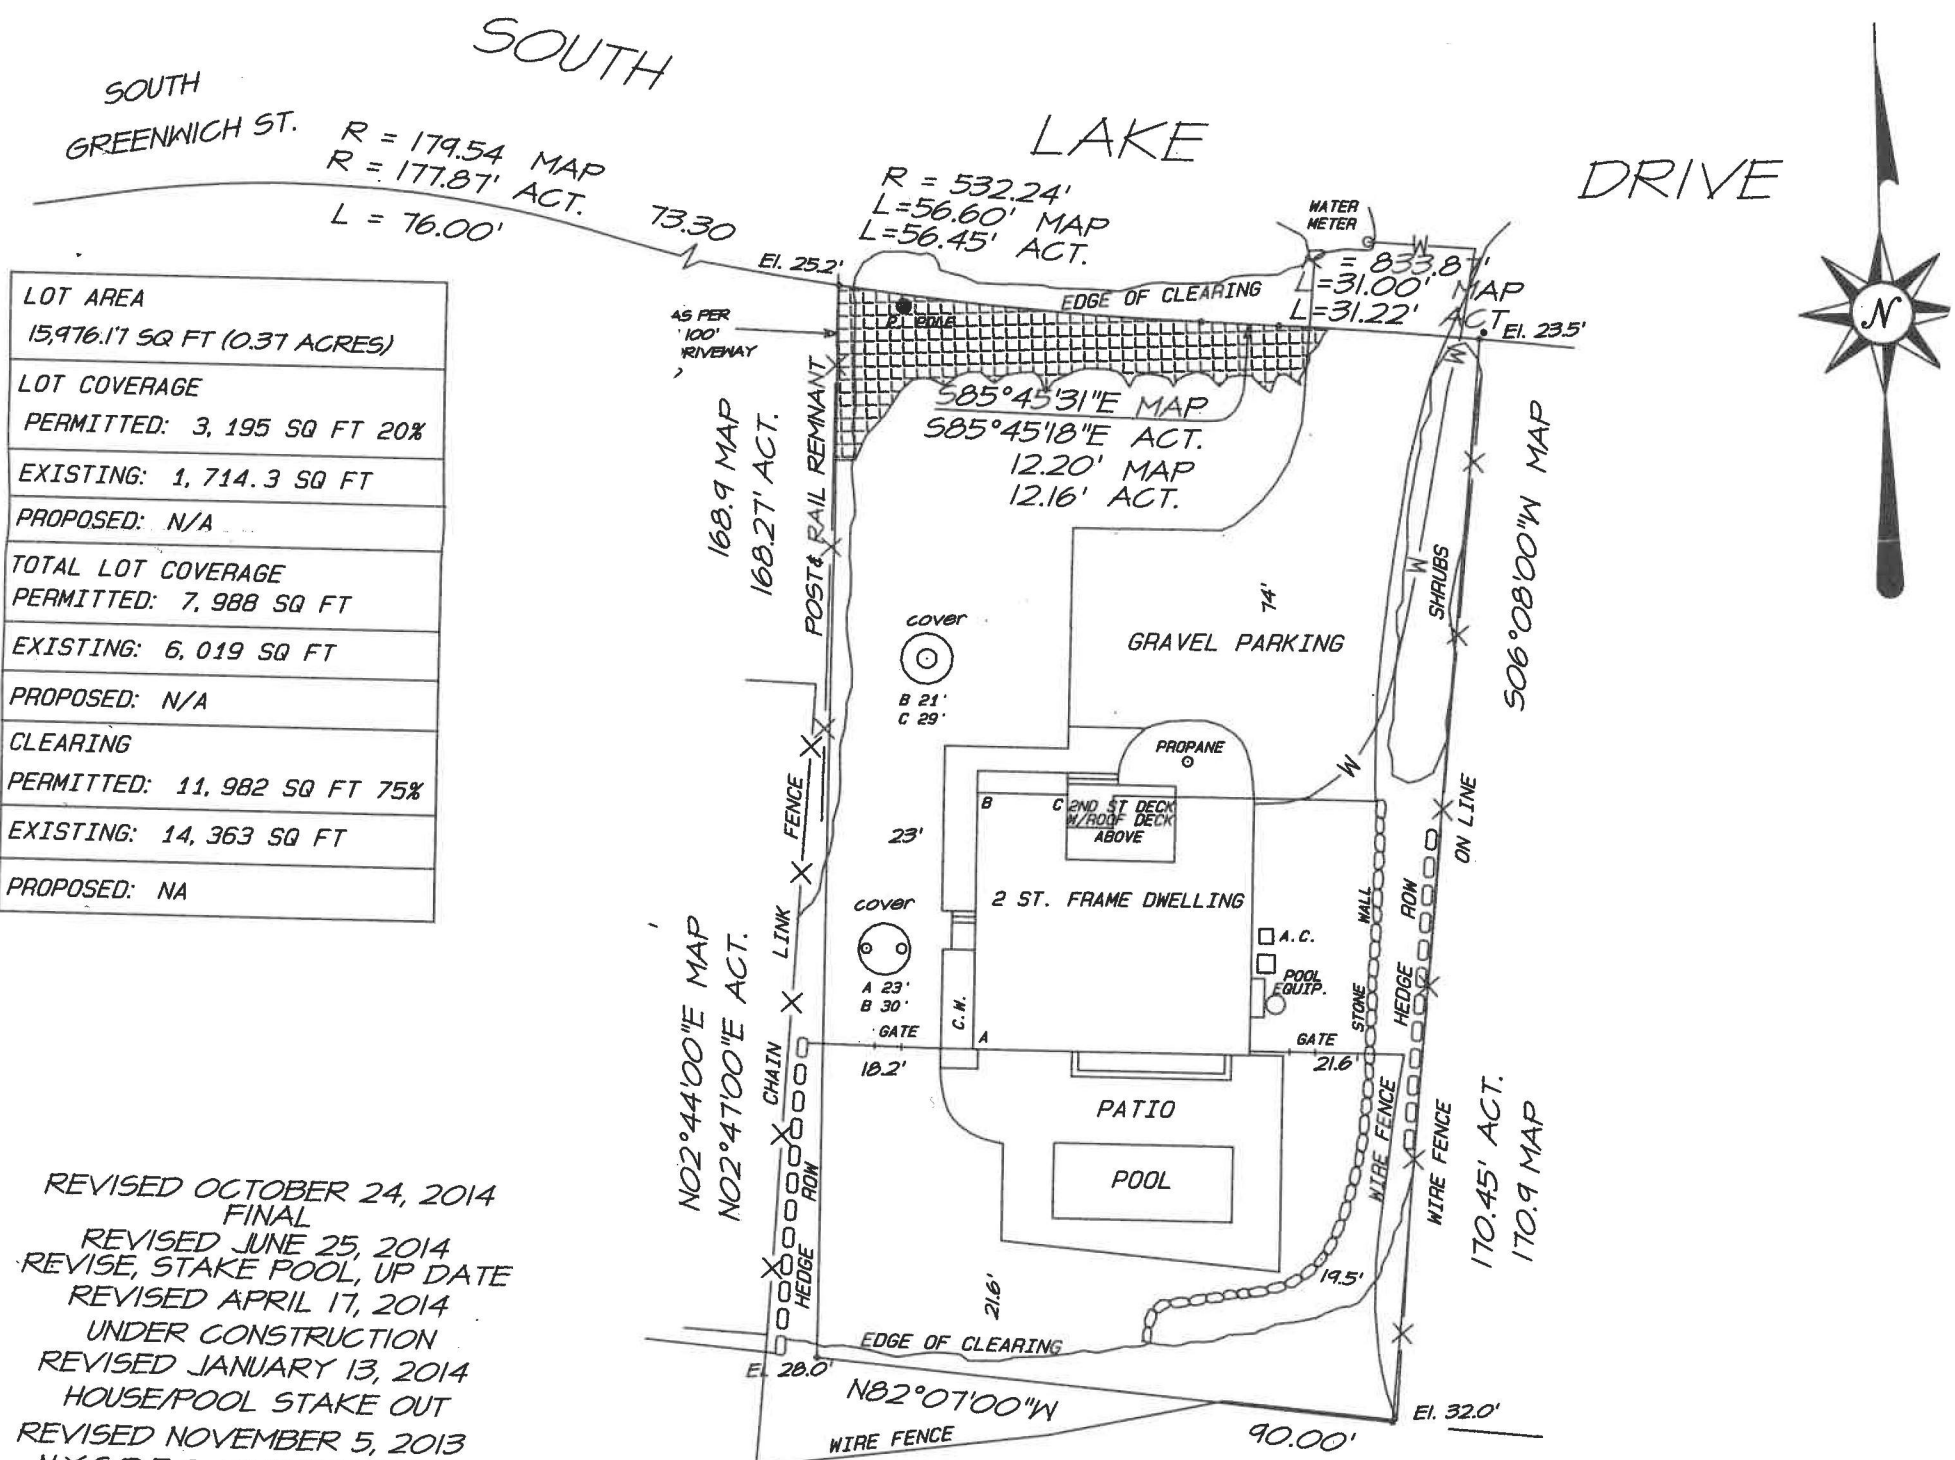

LOT AREA	15,976.17 SQ FT (0.37 ACRES)
LOT COVERAGE	PERMITTED: 3,195 SQ FT 20%
EXISTING:	1,714.3 SQ FT
PROPOSED:	N/A
TOTAL LOT COVERAGE	PERMITTED: 7,988 SQ FT
EXISTING:	6,019 SQ FT
PROPOSED:	N/A
CLEARING	PERMITTED: 11,982 SQ FT 75%
EXISTING:	14,363 SQ FT
PROPOSED:	NA

REVISED OCTOBER 24, 2014 FINAL  
 REVISED JUNE 25, 2014 REVISE, STAKE POOL, UP DATE  
 REVISED APRIL 17, 2014 UNDER CONSTRUCTION  
 REVISED JANUARY 13, 2014 HOUSE/POOL STAKE OUT  
 REVISED NOVEMBER 5, 2013 N.Y.S.D.E.C. REQUIREMENTS  
 REVISED JUNE 12, 2013 NEW HOUSE LOC., POOL, DECK, & SAN.  
 REVISED APRIL 3, 2013 SAN. COVER SURVEYED SEPTEMBER 10, 2012  
 WILLIAM J. WALSH

