


TAX MAP NO. 900 - 206 - 02 - 20
Area - 40,500 sq ft
Zone R-40

Refer to Filed Map No. L450 (Sept. 24, 1976)
in the County Clerk's Office.
The water line & septic system locations
are supplied by others.

Survive Highway

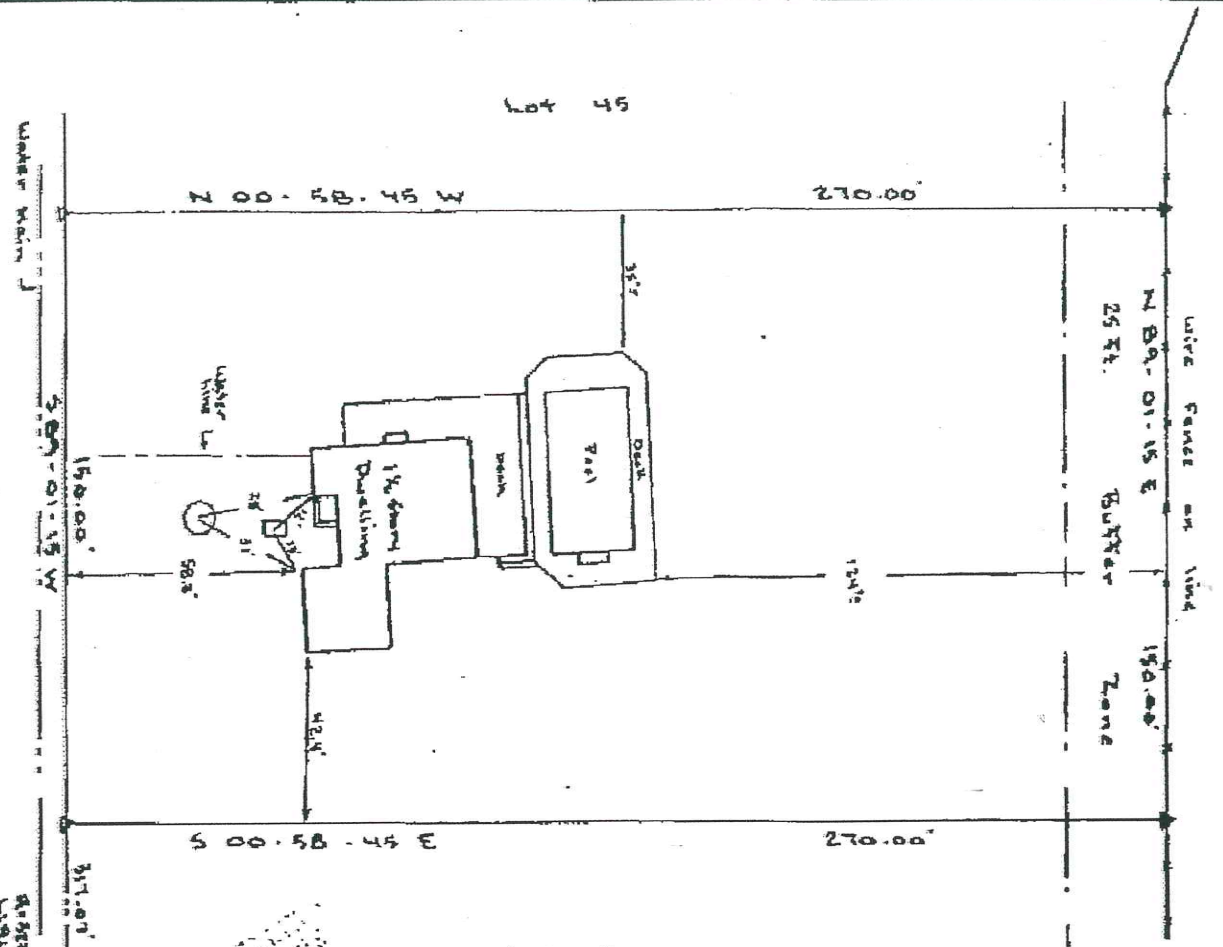

SUFFOLK COUNTY HEALTH DEPARTMENT
DATE SEP 8 - 1985 H. D. REF. # 12-5482
The sewage disposal and water supply
facilities for this location have been
inspected by this department and found
to be satisfactory. *Stephen A. Costa, P.E.*
Chief of General Engineering
Services

Pepi Court

Stuart Court

SURVEY OF PROPERTY
SITUATE
Lot 44 (No. 10 Pepi Court)
Squire Woods
Hampton Bays
TOWN OF SOUTHAMPTON
SUFFOLK COUNTY NEW YORK

CERTIFIED TO:
CHARLES M. DOLLIVER
LICENSE NO 32262



C-9724

Final Survey B-24,85
U.C. Survey 7-14-82

UNRECORDED SURVEY OF LOT 44
SECTION TWO OF THE NEW YORK CITY
SERIAL 100-100
EXCERPT: THIS SURVEY WAS NOT RECORDED
IN THE OFFICE OF THE CLERK OF THE
SUFFOLK COUNTY CLERK'S OFFICE
ON 7/14/82. THE SURVEY WAS
RECORDED IN THE OFFICE OF THE
CLERK OF THE SUFFOLK COUNTY
CLERK'S OFFICE ON 7/14/82.
THE SURVEY WAS RECORDED IN THE
OFFICE OF THE CLERK OF THE
SUFFOLK COUNTY CLERK'S OFFICE
ON 7/14/82.

Chicago Title Ins. Co. 8208-01067
SCALE 1" = 40'
SURVEYED MAR. 11, 1982
DENOTES MONUMENTS

JACOB M. BUCHHEIT
LICENSE NO 47400
Jacob M. Buchheit

DOLLIVER ASSOCIATES
LAND SURVEYORS
HAMPTON BAYS, N. Y.

BX 125 PG 25