


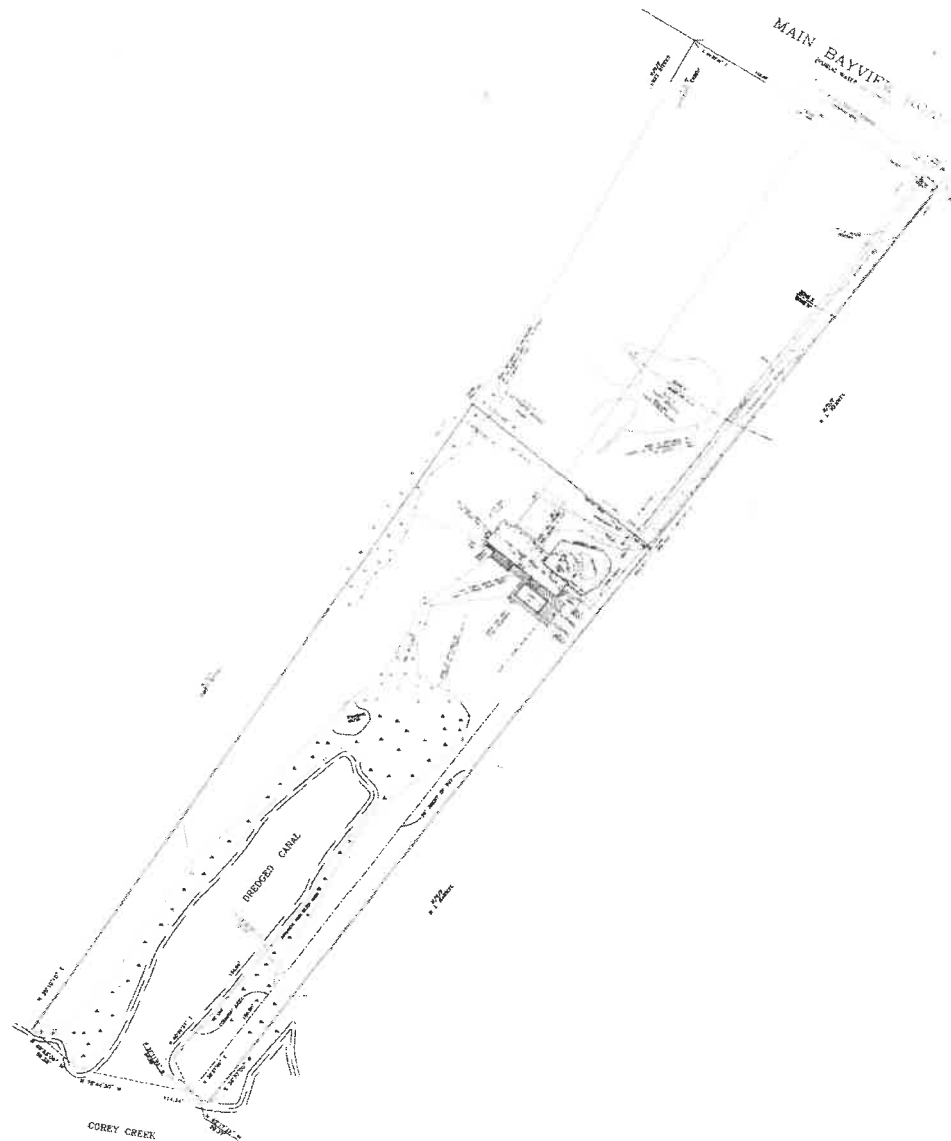

**SURVEY OF PROPERTY
SITUATED AT
SOUTHOLD
TOWN OF SOUTHOLD
SUFFOLK COUNTY, NEW YORK
S.C. TAX No. 1000-87-05-25
SCALE 1"=50'**

FEBRUARY 18, 2000
MAY 9, 2000 LOCATED WETLANDS
MAY 25, 2000 REVISED SITE PLAN
JUNE 28, 2000 LATH FOR N.Y.S.D.E.C. INSPECTION
SEPTEMBER 16, 2000 ADDED WETLANDS
DECEMBER 8, 2000 REVISED PLOI PLAN
DECEMBER 14, 2000 REVISED BUFFER
JANUARY 8, 2001 SET LATH FOR N.Y.S.D.E.C. INSPECTION
APRIL 23, 2001 REVISED MAP
JULY 19, 2001 ADDED TEST HOLE No. 2
SEPTEMBER 17, 2001 REVISED SITE PLAN
NOVEMBER 5, 2001 ADDED SETBACKS TO R.I.W.'S
DECEMBER 6, 2001 REVISED PROPOSED DONORAGE RINGS
OCTOBER 5, 2004 REVISED PROPOSED POOL & HOUSE
NOVEMBER 21, 2005 FILE & GRADY LOCATION
FEBRUARY 3, 2008 ADDED POOL HOUSE
JULY 28, 2008 FINAL SURVEY
NOVEMBER 3, 2008 UPDATE FINAL SURVEY

AREA = 148,418.9 sq. ft.
(10 AC. LMS) 3,407 sq. ft.
S.C.S.A.S. No. 810-85-0212
CERTIFIED TO:
LGA 02001

- NOTES:**
1. REFERENCE TO RECORDS TO BE MADE BY THE SURVEYOR
 2. THE SURVEYOR HAS BEEN ADVISED BY THE OWNER THAT THE PROPERTY IS NOT SUBJECT TO ANY EASEMENTS OR RIGHTS OF WAY.
 3. THE SURVEYOR HAS BEEN ADVISED BY THE OWNER THAT THE PROPERTY IS NOT SUBJECT TO ANY EASEMENTS OR RIGHTS OF WAY.
 4. THE SURVEYOR HAS BEEN ADVISED BY THE OWNER THAT THE PROPERTY IS NOT SUBJECT TO ANY EASEMENTS OR RIGHTS OF WAY.
 5. THE SURVEYOR HAS BEEN ADVISED BY THE OWNER THAT THE PROPERTY IS NOT SUBJECT TO ANY EASEMENTS OR RIGHTS OF WAY.
 6. THE SURVEYOR HAS BEEN ADVISED BY THE OWNER THAT THE PROPERTY IS NOT SUBJECT TO ANY EASEMENTS OR RIGHTS OF WAY.
 7. THE SURVEYOR HAS BEEN ADVISED BY THE OWNER THAT THE PROPERTY IS NOT SUBJECT TO ANY EASEMENTS OR RIGHTS OF WAY.
 8. THE SURVEYOR HAS BEEN ADVISED BY THE OWNER THAT THE PROPERTY IS NOT SUBJECT TO ANY EASEMENTS OR RIGHTS OF WAY.
 9. THE SURVEYOR HAS BEEN ADVISED BY THE OWNER THAT THE PROPERTY IS NOT SUBJECT TO ANY EASEMENTS OR RIGHTS OF WAY.
 10. THE SURVEYOR HAS BEEN ADVISED BY THE OWNER THAT THE PROPERTY IS NOT SUBJECT TO ANY EASEMENTS OR RIGHTS OF WAY.

THE SURVEYOR HAS BEEN ADVISED BY THE OWNER THAT THE PROPERTY IS NOT SUBJECT TO ANY EASEMENTS OR RIGHTS OF WAY.



Joseph A. Ingegno
Land Surveyor

510 Tuxedo - Manhattan 212-751-1721
PHONE (617)777-2090 (212)751-1721
OFFICE LOCATED AT 212 BROADWAY, NEW YORK, N.Y. 10004
NEW YORK, N.Y. 10004 212-751-1721