


DISTRICT	SECTION	BLOCK	PARCEL	SUFFOLK COUNTY TAX MAP
				0900
				95.00
				02.00
				025.000

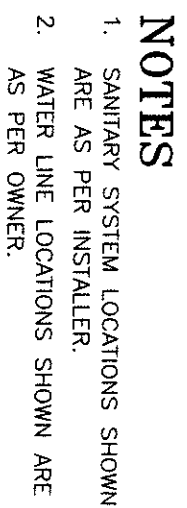

LESTER HOLDEN, L.S. 49548
S. H. W. and S., LAND SURVEYORS, P.C.
SQUIRES, HOLDEN, WEISENBACHER and SMITH
LAND SURVEYING ~ LAND PLANNING ~ ENGINEERING
SOUTHAMPTON ~ NEW YORK

AREA = 20,728 S.F. (0.476 AC.)
SCALE: 1" = 30'