HAMPTON
TY, NEW YORK
019-04-31
SF. = 0.5120 ACRES

E OF RIGHT OF WAYS.
ASEMENTS OF RECORD
ARE NOT GUARANTEED.

C AND SEPTIC SYSTEM
. B.O.H. REF. No. R09-08-0337
ONS BY SURVEYOR

CATION

LOCATION

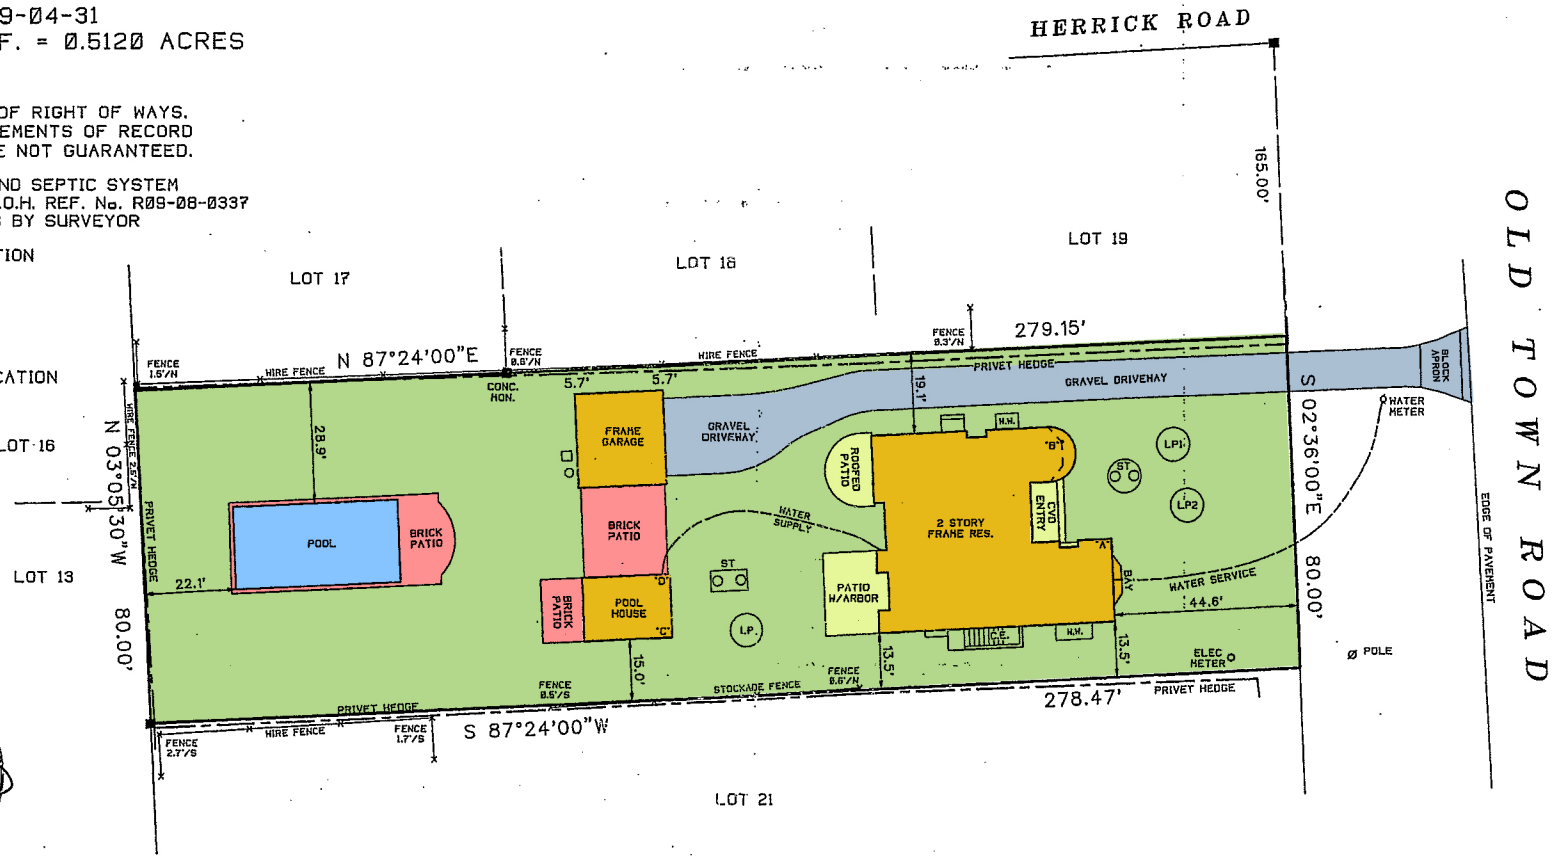


N TO THIS SURVEY IS A VIOLATION
E EDUCATION LAW.

ING THE LAND SURVEYORS INKED
BERED TO BE A VALID TRUE COPY.

ATED HEREON SHALL RUN ONLY TO
EPARED. AND ON HIS BEHALF TO
CY AND LENDING INSTITUTION
F THE LENDING INSTITUTION.
TRANSFERABLE TO ADDITIONAL

SURVEYED BY:
STEVEN BARYLSKI
N.Y.S. Lic. No. 050453
41 MEETING HOUSE LAN
SOUTHAMPTON, N.Y. 1190
FEBRUARY 19, 2008

7-22-2008: ADD SITE PLAN
8-19-2008: REVISED POOL
9-25-2009: FINAL SURVEY