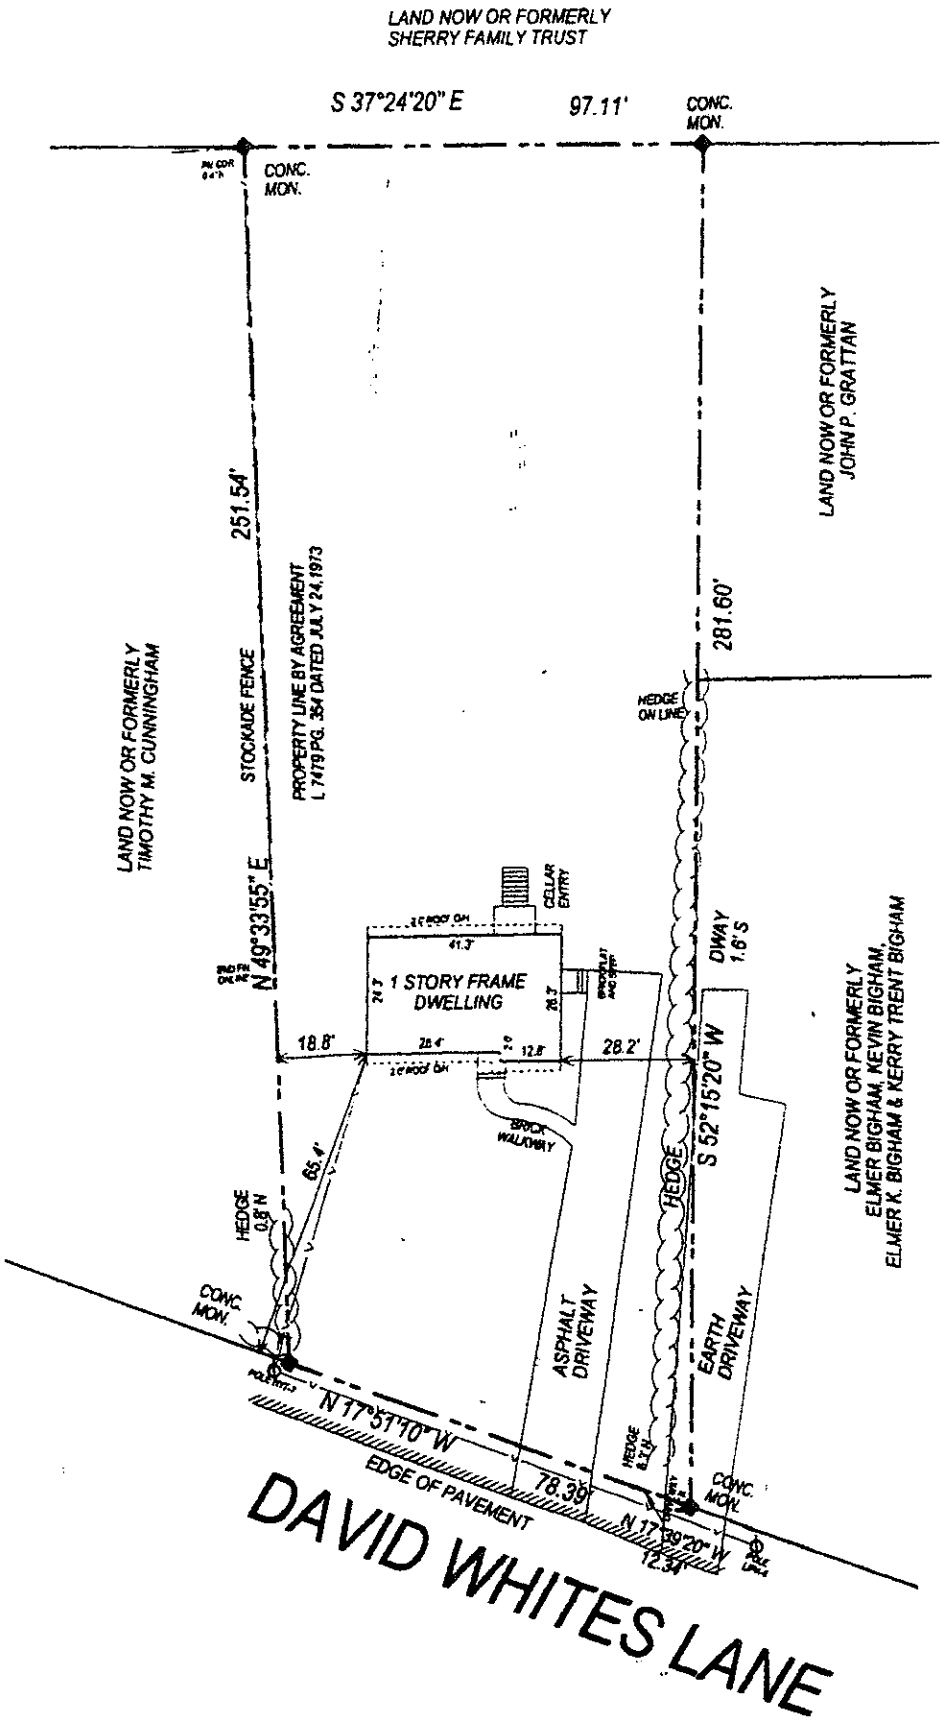
LAND NOW OR FORMERLY
SHERRY FAMILY TRUST
S 37°24'20" E
97.11'
CONC. MON.
CONC. MON.
LAND NOW OR FORMERLY
JOHN P. GRATTAN
251.54'
281.60'
PROPERTY LINE BY AGREEMENT
L 7479 PG. 354 DATED JULY 24, 1973
STOCKADE FENCE
LAND NOW OR FORMERLY
TIMOTHY M. CUNNINGHAM
HEDGE ON LINE
N 49°33'55" E
CELLAR ENTRY
1 STORY FRAME DWELLING
DWAY 1.6' S
18.8'
28.2'
S 52°15'20" W
BRICK WALKWAY
HEDGE
65.4'
HEDGE 0.8' N
LAND NOW OR FORMERLY
ELMER BIGHAM, KEVIN BIGHAM,
ELMER K. BIGHAM & KERRY TRENT BIGHAM
CONC. MON.
ASPHALT DRIVEWAY
EARTH DRIVEWAY
N 17°51'10" W
EDGE OF PAVEMENT
78.39'
N 17°39'20" W
12.34'
CONC. MON.
DAVID WHITES LANE