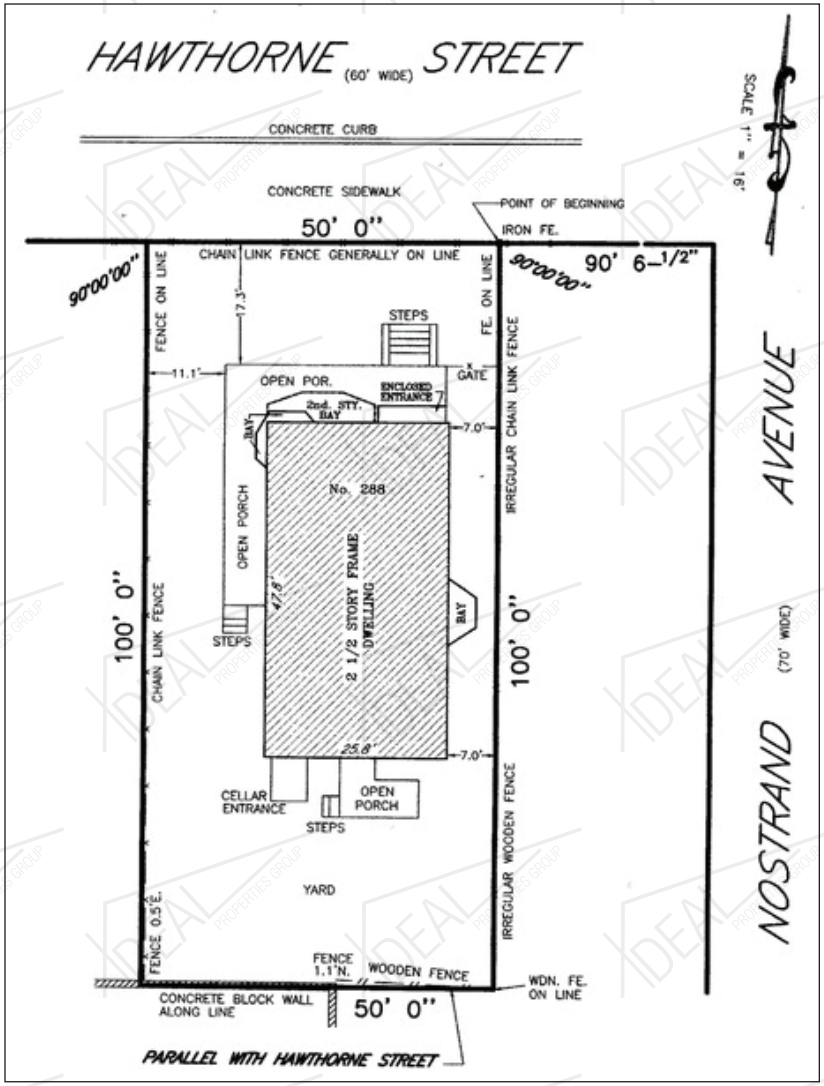

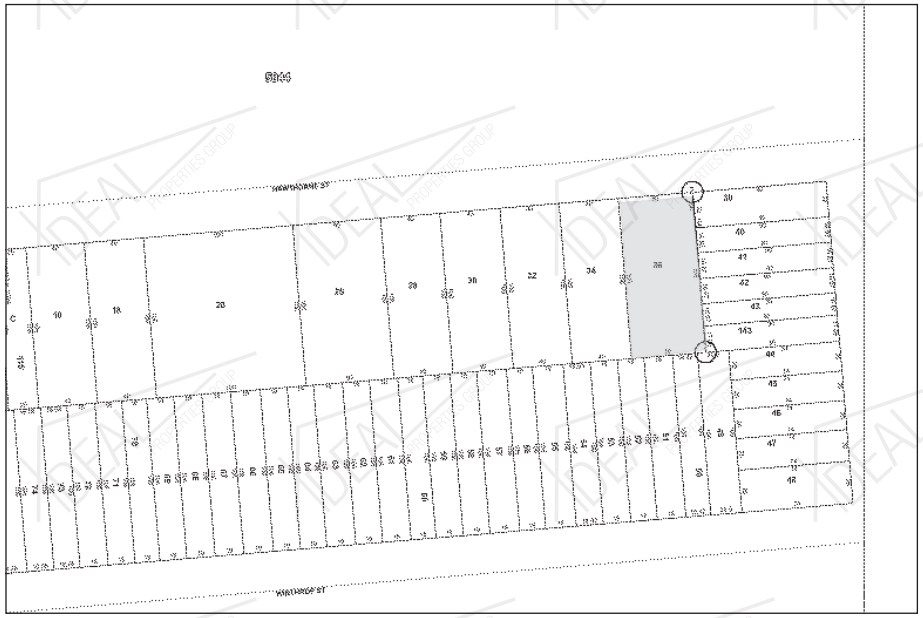

Not to scale. All dimensions are approximate and for illustration purpose only. Plans and dimensions may contain variations from floor to floor, and from unit to unit. Any dimensions shown herein are approximate. Floor plans are provided for informational purposes only. The actual floor plans of the residence may differ and will need to be drawn up by your architect or other professional. Any alternate floorplans are presented for illustration purposes only and no representation is made whatsoever of their adequacy or suitability for any submission or approval.