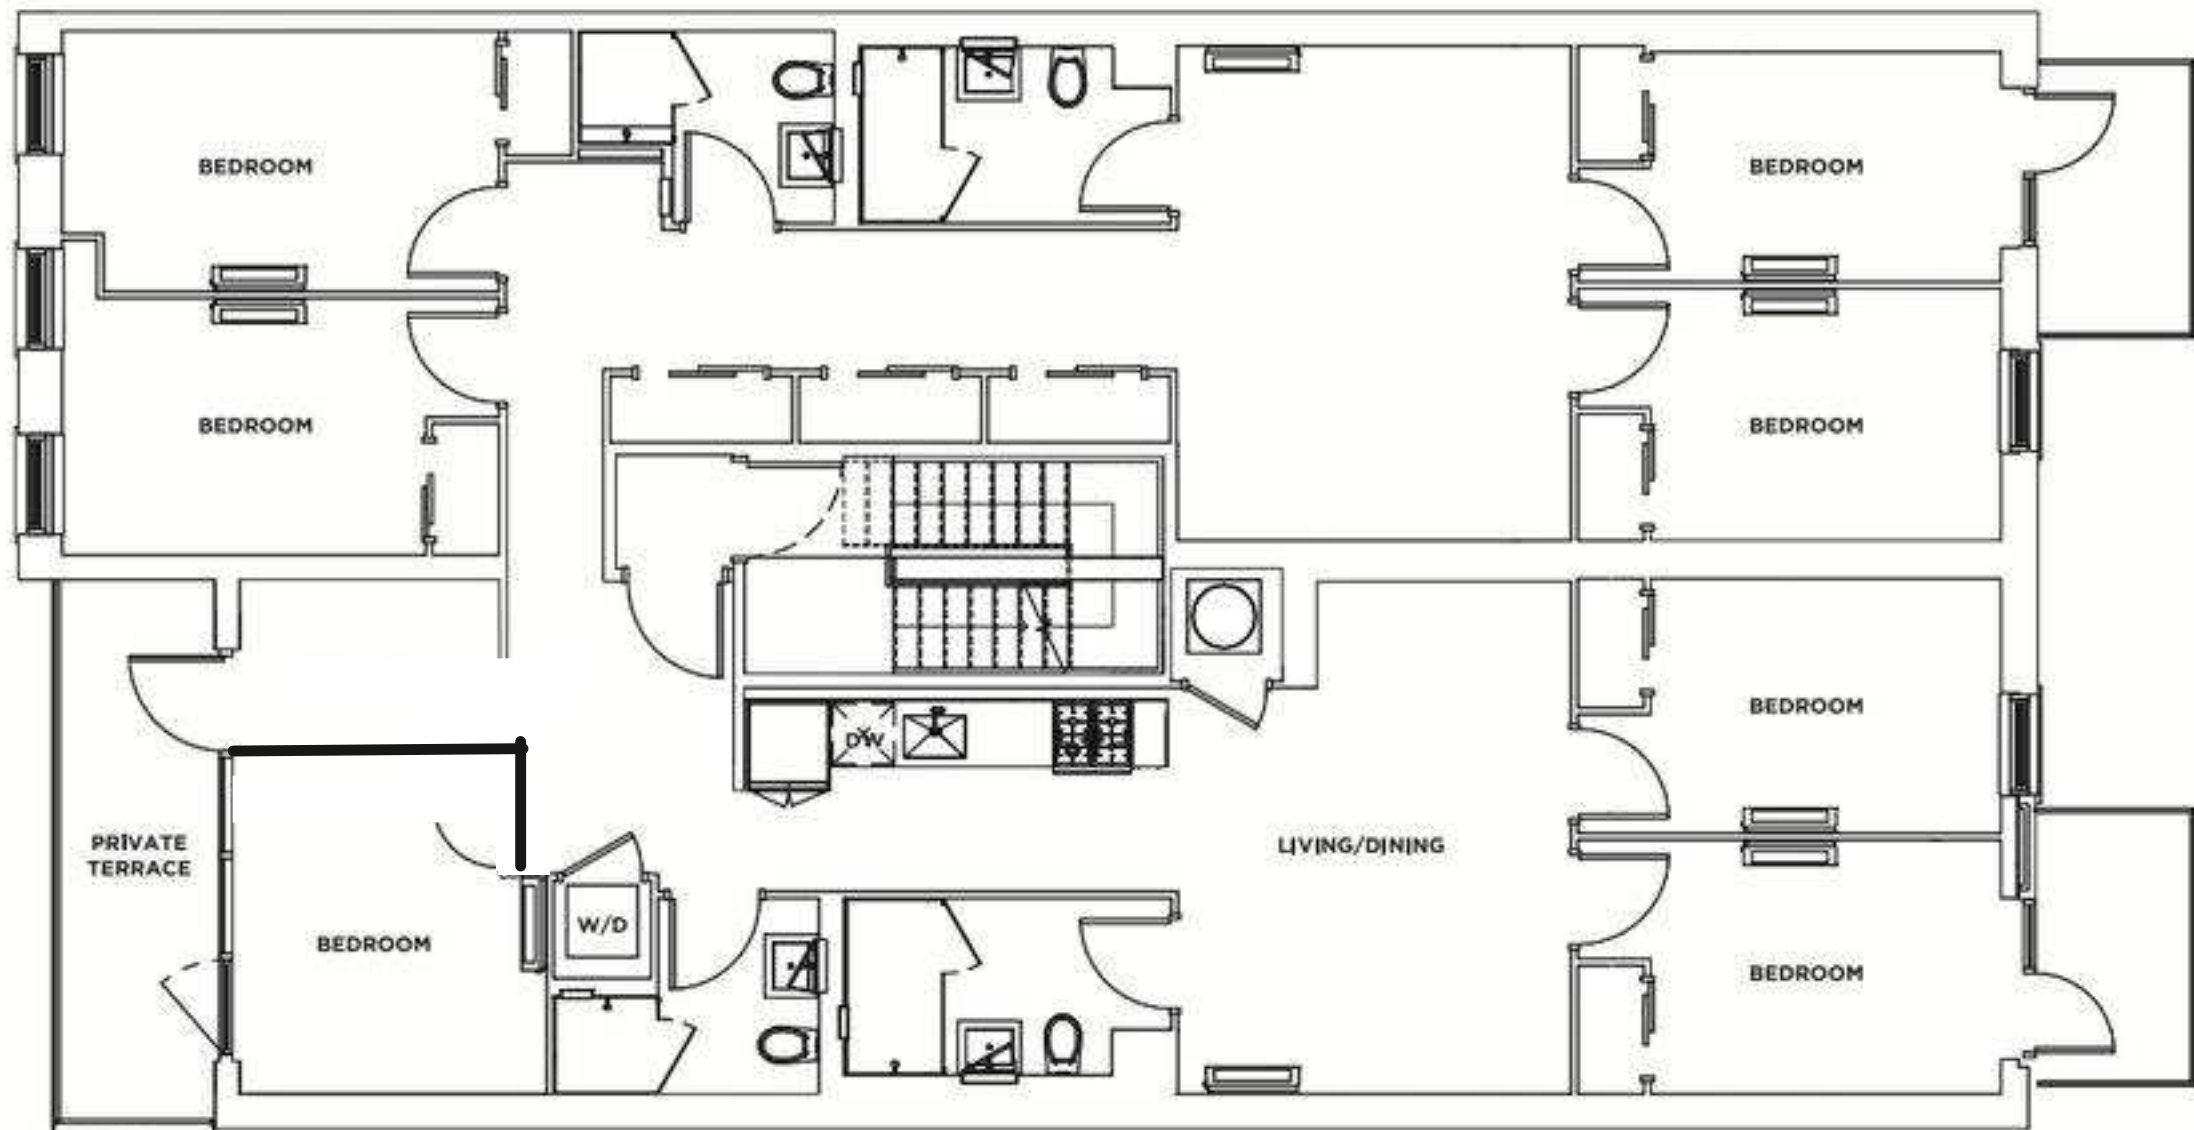


174-176 First Ave

East Village

*Slater*