


SCHEDULE A

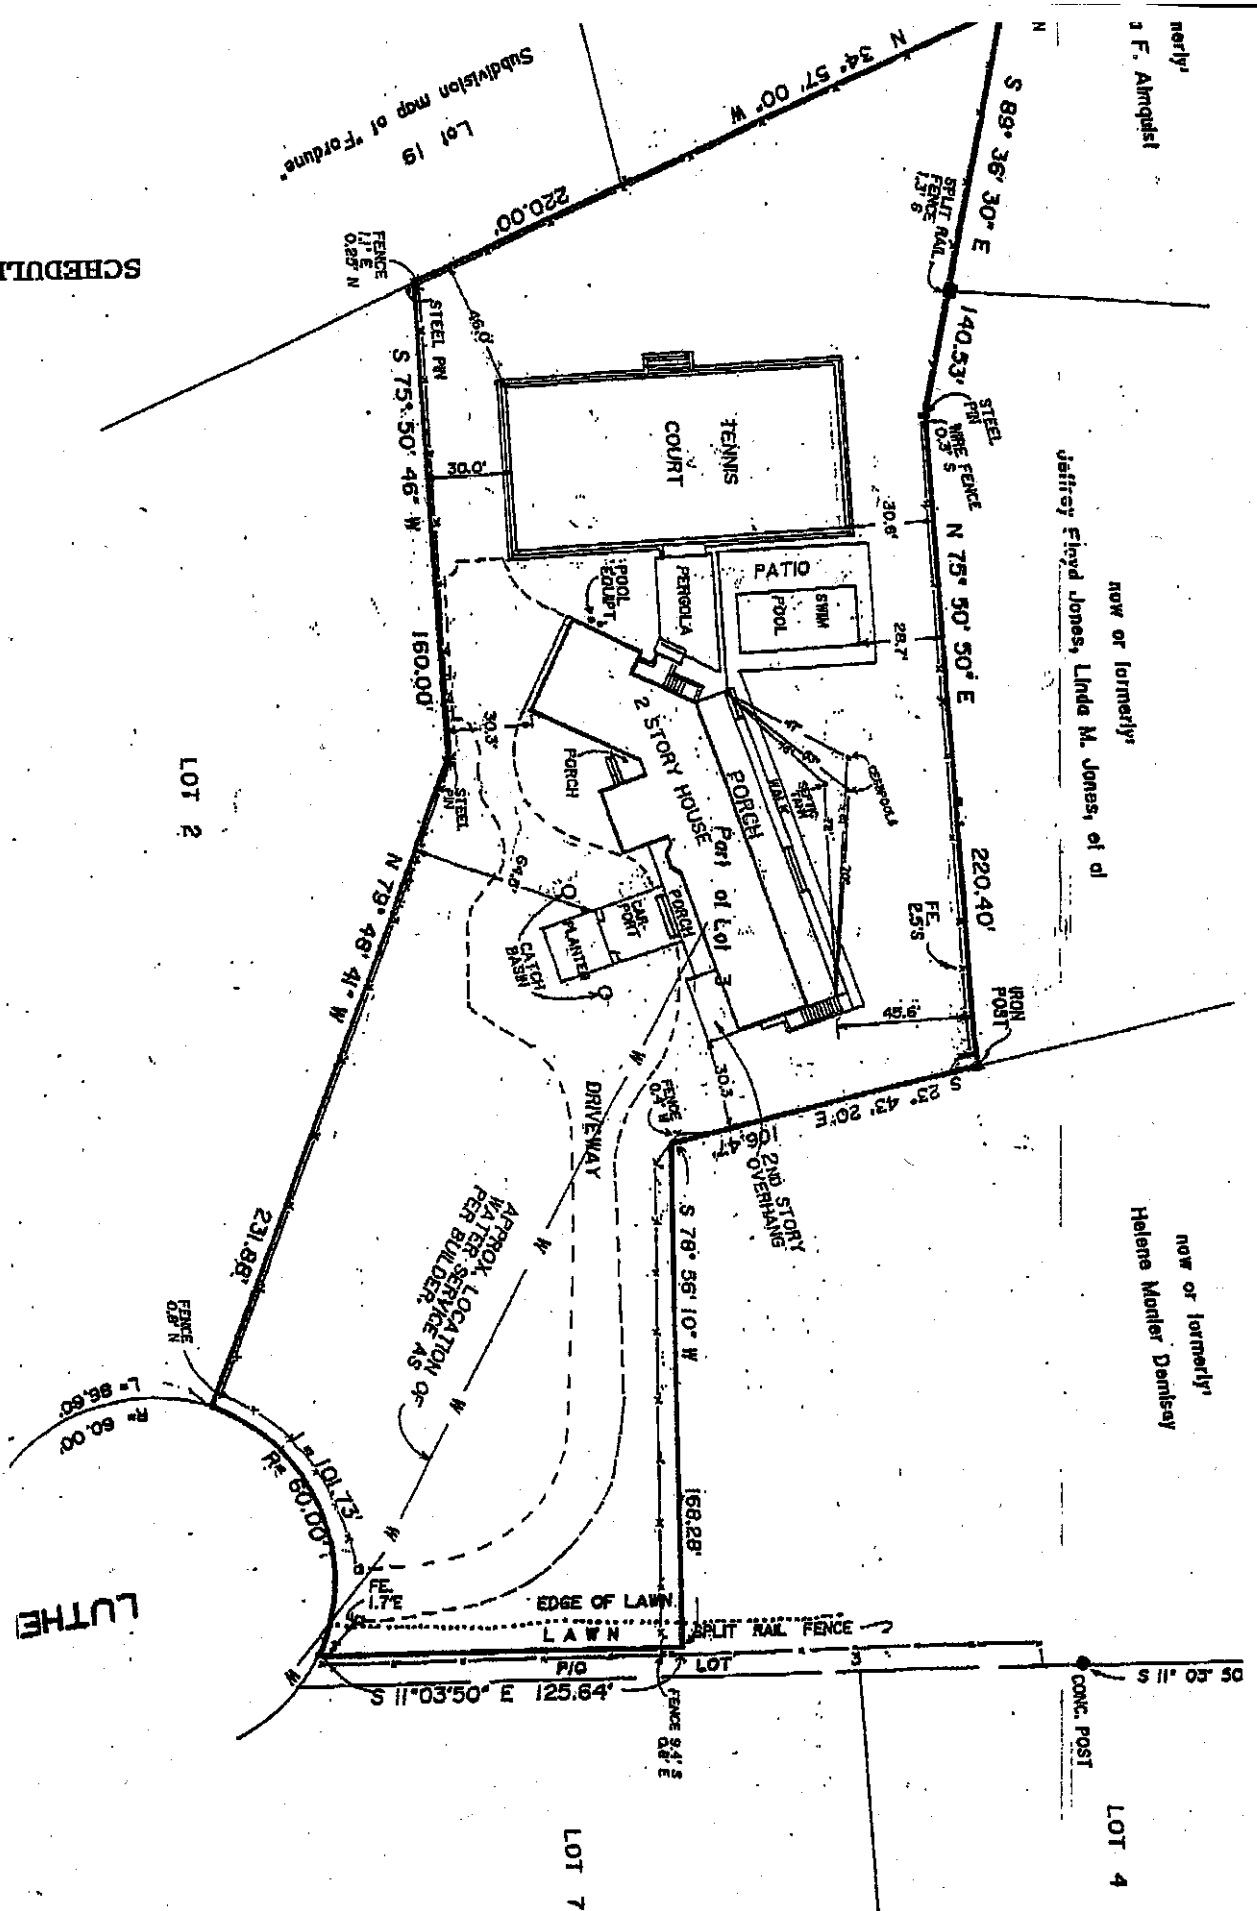

now or formerly
J. F. Almqvist

now or formerly
Jeffrey Floyd Jones, Linda M. Jones, et al

now or formerly
Helene Marler Danilsey