


THE OFFSETS (OR DIMENSIONS) SHOWN HEREON FOR THE STRUCTURES TO THE LINES ARE FOR A SPECIFIC PURPOSE AND USE AND THEREFORE ARE NOT INTENDED TO GUIDE THE ERECTION OF FENCES, RETAINING WALLS, POOLS, PATIOS, PLAYING AREAS, ADDITION TO BUILDINGS OR ANY OTHER CONSTRUCTION.

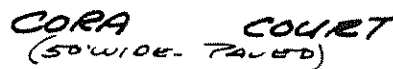

Certification indicated hereon shall run only to the person for whom the survey is prepared and on his behalf to the title company, government, or other institution listed hereon. No other person or institution shall be entitled to rely on the results of the survey or on the certification hereon.

Copies of this survey are printed on
inked seat or embossed so that
no true copy.



FILE NO 18-P-35

Authorized Signature

Measurements U S Standard
Scale 1 —

Monuments Shown Thus

Stakes Shown Thus