

THIS MAP HAS BEEN PREPARED AS AN ACCOMMODATION TO THE CLIENT FOR USE IN APPLYING TO THE BUILDING DEPARTMENT FOR A BUILDING PERMIT OR A CERTIFICATE OF OCCUPANCY. THIS MAP IS NOT INTENDED FOR USE AS A TITLE SURVEY. ITEMS INDICATING EVIDENCE OF POSSESSION, IF ANY EXIST, WHICH MAY AFFECT TITLE MAY NOT BE SHOWN.

NOTE:
LOCATIONS AND SIZES OF
SEPTIC TANK AND CESSPOOLS ARE
PROVIDED BY CONTRACTOR.
S.C.D.H.S. REF. NO: R09-07-0089.

UNAUTHORIZED ALTERATION OR ADDITION TO A SURVEY MAP BEARING A LICENSED LAND SURVEYOR'S SEAL IS A VIOLATION OF SECTION 7209, SUBDIVISION 2, OF THE NEW YORK STATE EDUCATION LAW.

ONLY COPIES FROM THE ORIGINAL OF THIS SURVEY MARKED WITH AN ORIGINAL OF THE LAND SURVEYOR'S EMBOSSED SEAL OR INKED SEAL SHALL BE CONSIDERED TO BE VALID TRUE COPIES.

CERTIFICATIONS INDICATED HEREON SIGNIFY THAT THIS SURVEY WAS PREPARED IN ACCORDANCE WITH THE EXISTING CODE OF PRACTICE FOR LAND SURVEYS ADOPTED BY THE NEW YORK STATE ASSOCIATION OF PROFESSIONAL LAND SURVEYORS. SAID CERTIFICATIONS SHALL RUN TO THE PERSON FOR WHOM THE SURVEY IS PREPARED, AND ON HIS BEHALF TO THE TITLE COMPANY, GOVERNMENTAL AGENCY AND LENDING INSTITUTION LISTED HEREON. CERTIFICATIONS ARE NOT TRANSFERABLE TO ADDITIONAL INSTITUTIONS OR SUBSEQUENT OWNERS. CERTIFICATIONS RUN ONLY TO THE LAST FIELD SURVEY DATE.

NO CERTIFICATION IS MADE AS TO THE EXISTENCE OR NON-EXISTENCE OF EASEMENTS OR RIGHTS-OF-WAY AFFECTING THIS PROPERTY. THE LOCATIONS OF EASEMENTS OR RIGHTS-OF-WAY OF RECORD ARE SHOWN HEREON ONLY IF COPIES OF THE INSTRUMENTS ARE PROVIDED TO THE SURVEYOR.

SURVEYED: SEPTEMBER 30, 2008
JANUARY 20, 2009 (DRIVEWAY LOCATION ONLY; SNOW-COVERED GROUND)

THE RAYNOR GROUP, P.E. & L.S. PLLC


CIVIL ENGINEERS

SURVEYORS

DEERFIELD GREEN
WATER MILL, N.Y. 11976

SITE PLANNERS

P.O. BOX 720
(631) 726-7600

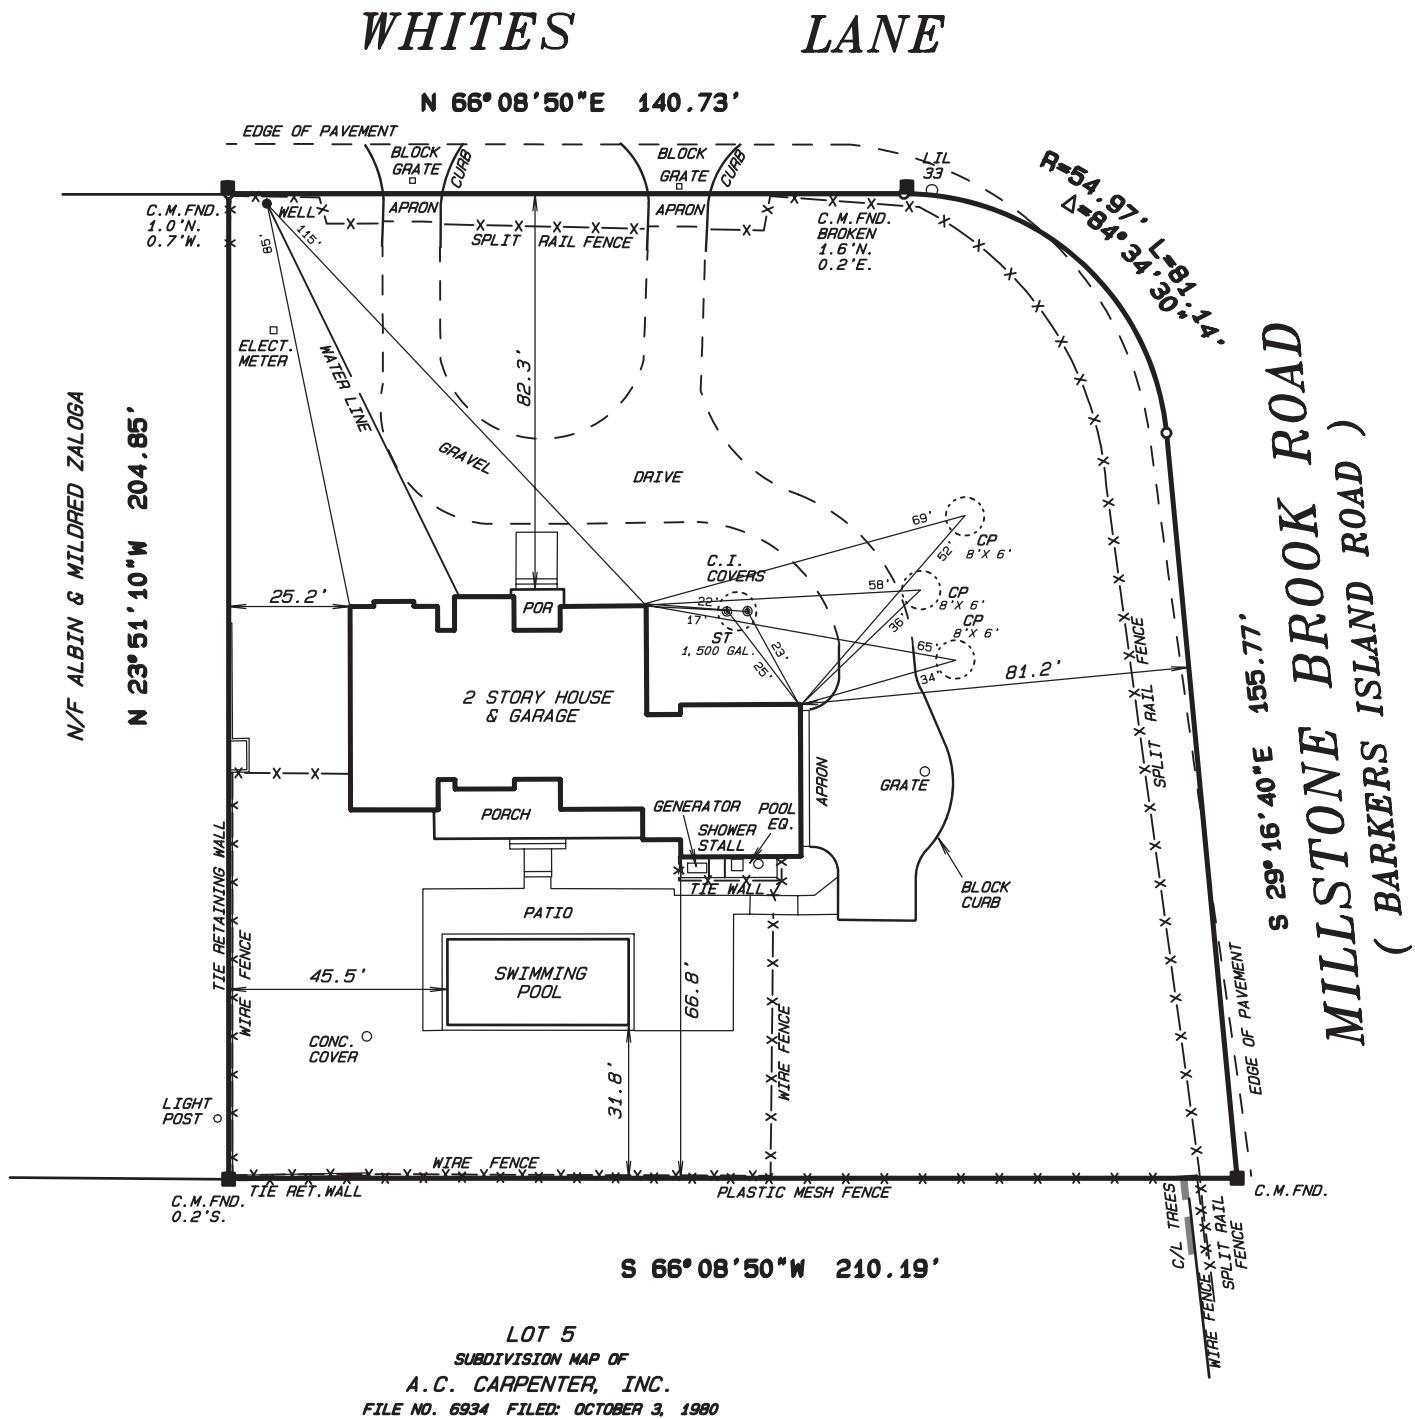

MAP OF SURVEY

PREPARED FOR

EDGAR B. COOPER

SITUATE

TUCKAHOE

TOWN OF SOUTHAMPTON
SUFFOLK COUNTY, N.Y.

SCALE: 1" = 40'

AREA = 40,544 S.F.

TAX MAP NO.: 0900-128.00-02.00-005.000

THE BASIS FOR THIS SURVEY IS A DESCRIPTION FOUND IN A DEED MADE BY A.C. CARPENTER, INC. TO ALBIN ZALOGA AND MILDRED C. ZALOGA DATED DECEMBER 12, 1967 AND RECORDED IN THE SUFFOLK COUNTY CLERK'S OFFICE ON JANUARY 12, 1968 IN LIBER 6287 AT PAGE 51.

© 2009 THE RAYNOR GROUP, P.E. & L.S. PLLC
UNAUTHORIZED REPRODUCTION IS UNLAWFUL. ALL RIGHTS RESERVED.