


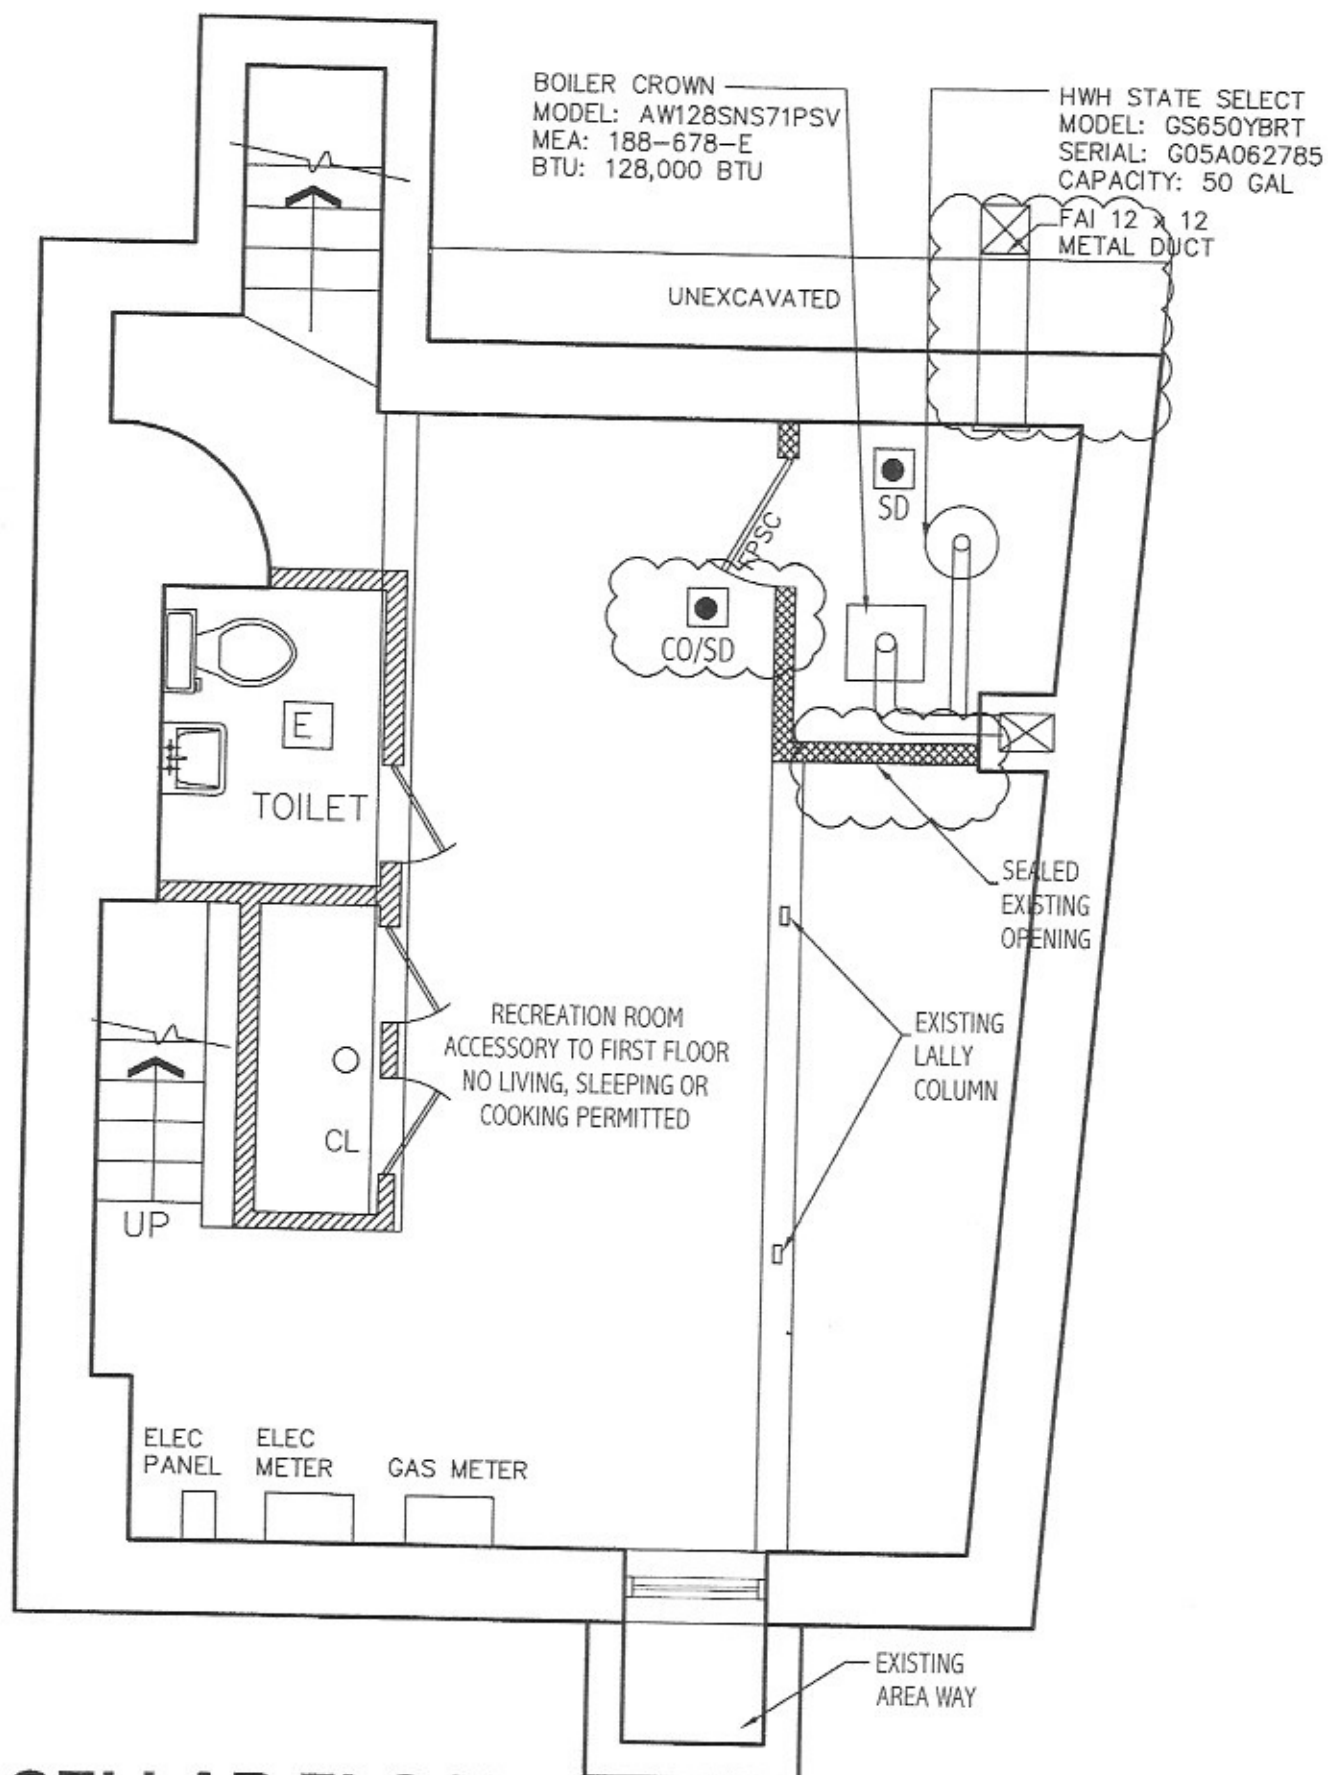

CELLAR FLOOR PLAN

1 / 4" = 1' -0"

1025 WILLOUGHBY