



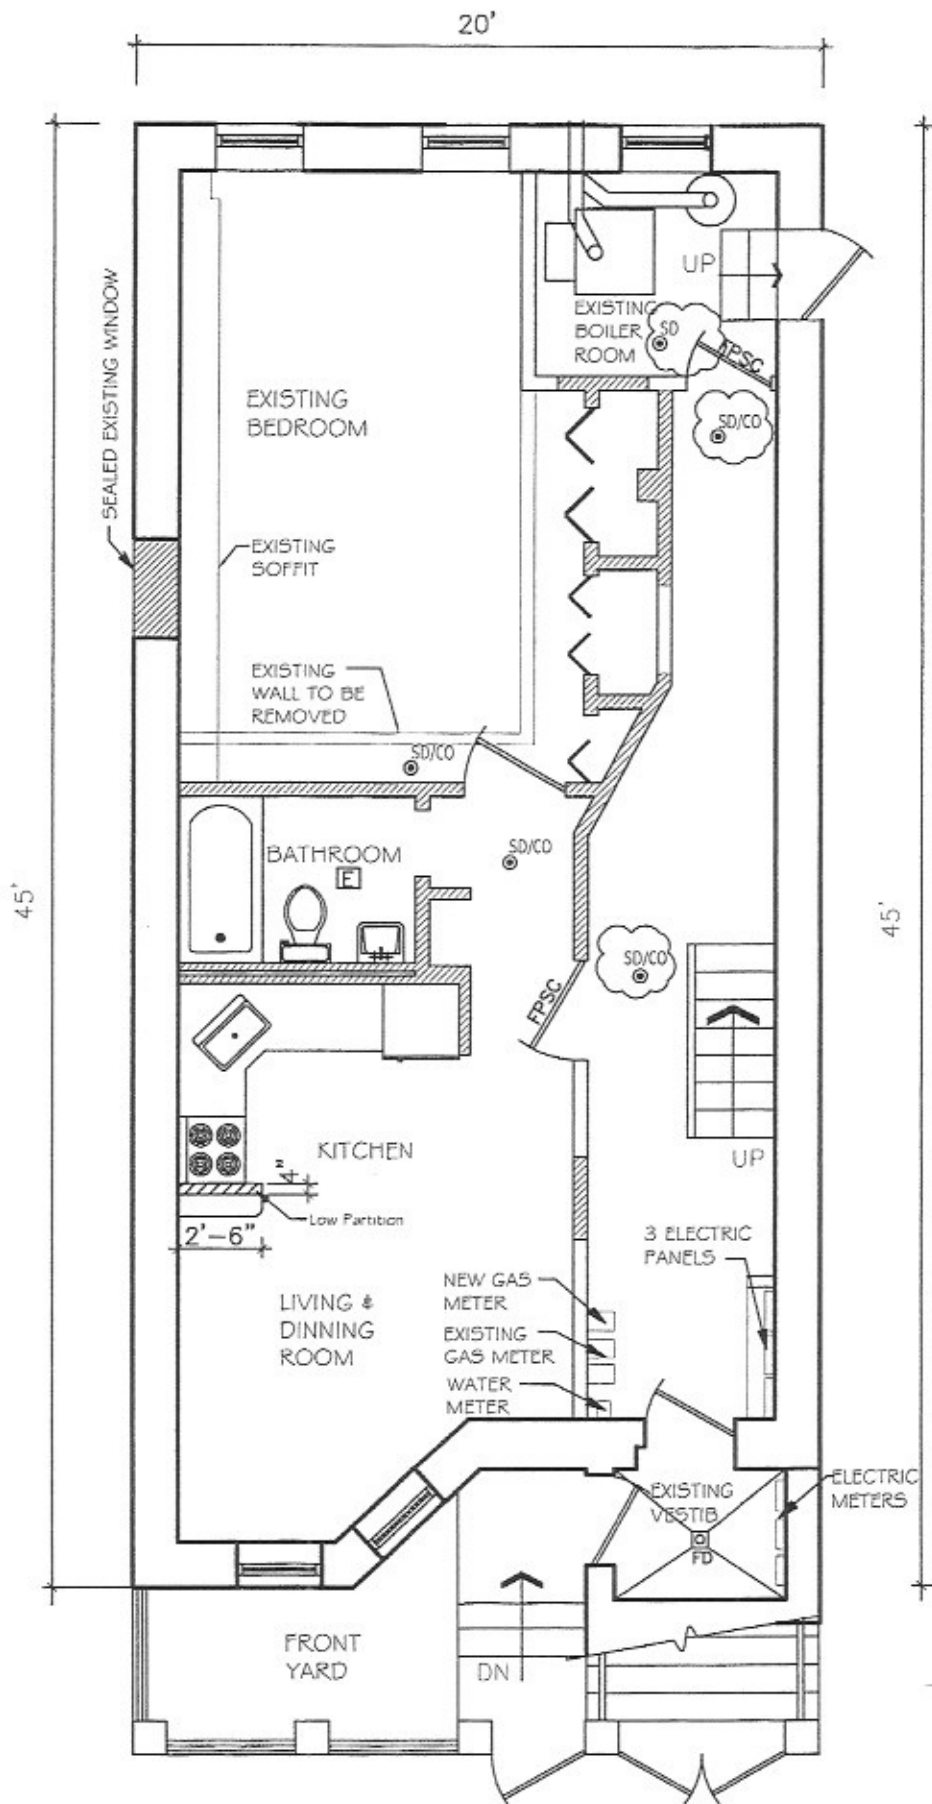


## BASEMENT FLOOR PLAN

1/4" = 1'-0"

1023 Willoughby

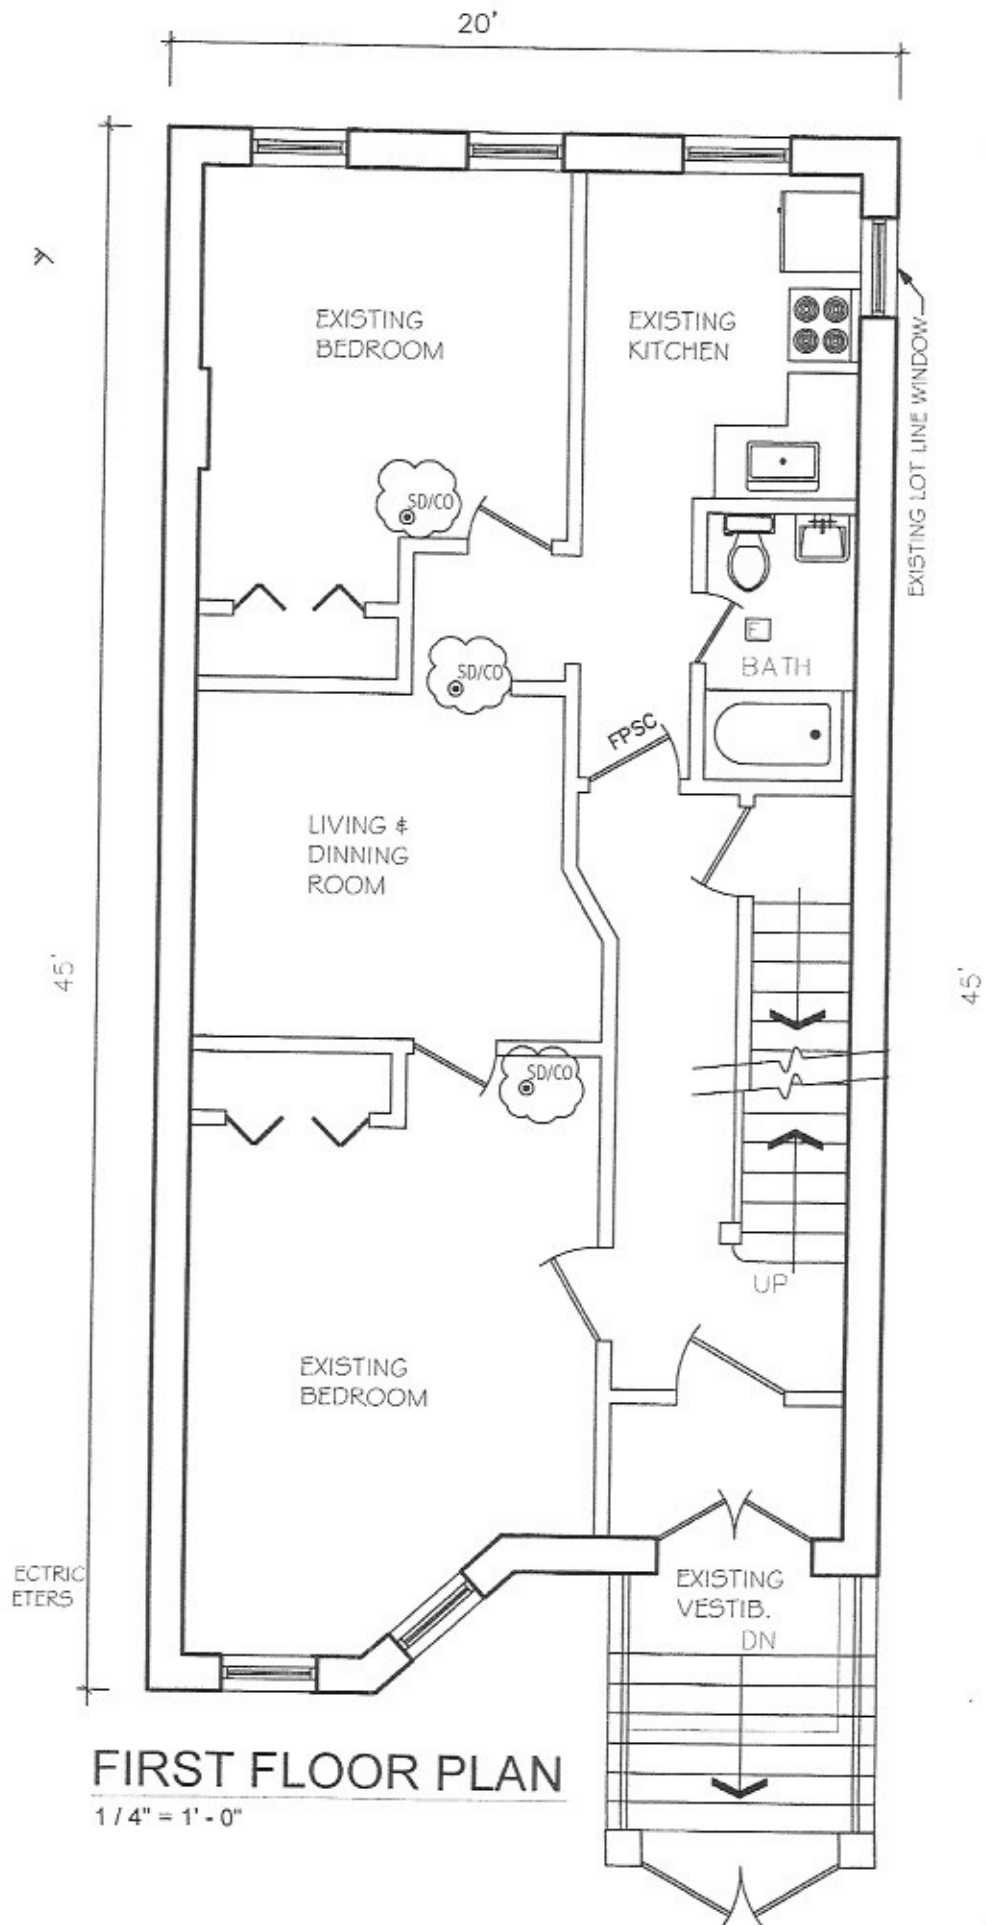

1023 willoughby

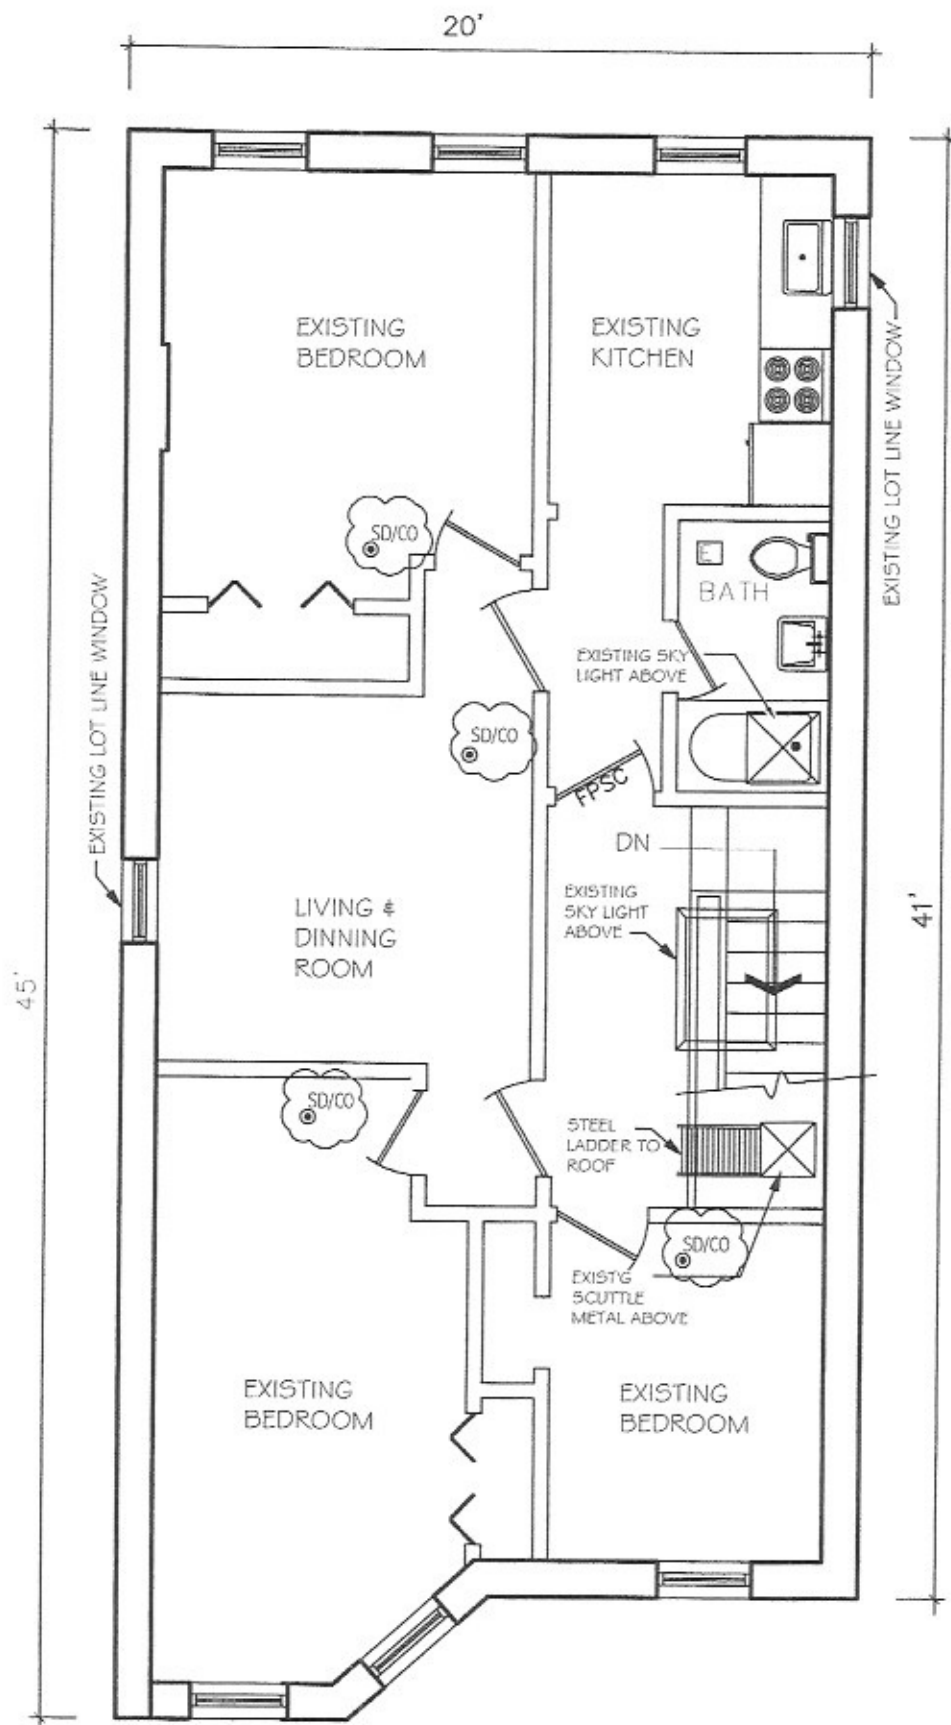

## SECOND FLOOR PLAN

1/4" = 1'-0"

1023 Willoughby