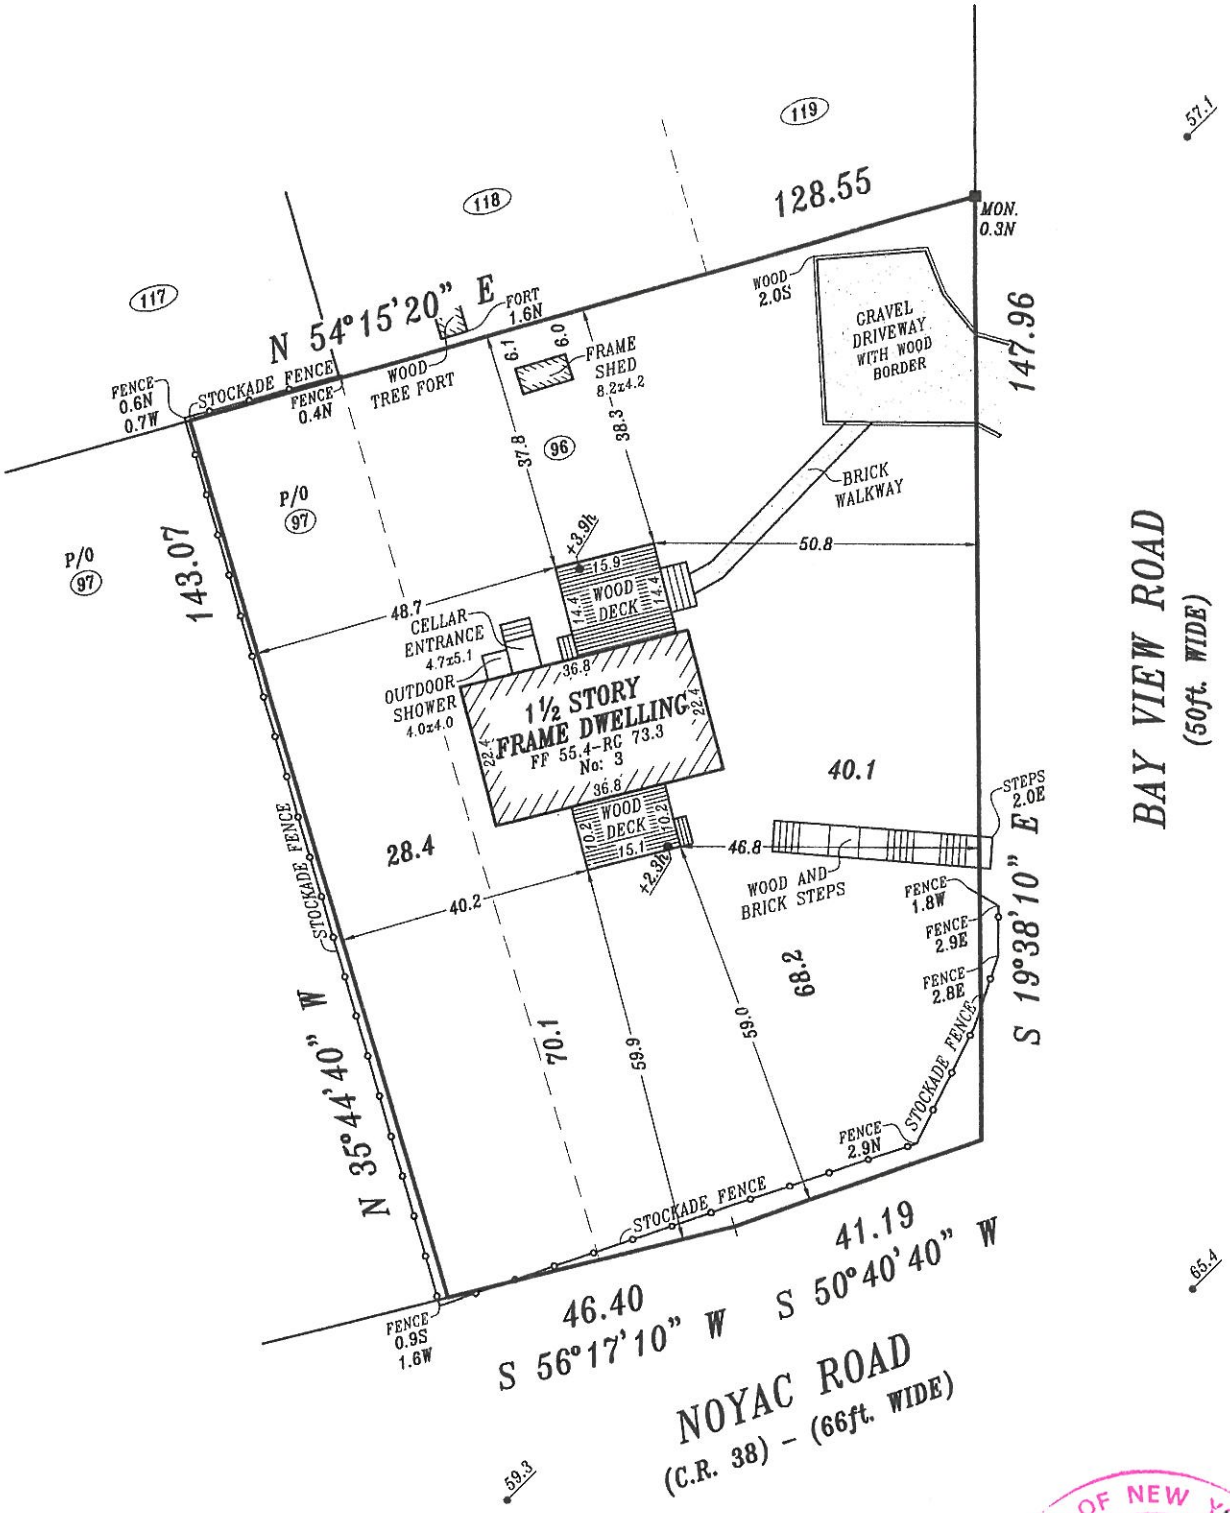

STATE OF NEW YORK
ELIZABETH G. McQUILKIN
NO. 050211
LICENSED LAND SURVEYOR

CERTIFIED TO:

SCALE: 1" = 30'
DRAWN BY: S.G.
FILE No: 0131-14

SURVEY OF LOT 96 AND PART OF LOT 97

LISA M. QUILLKIN