


SURVEYED FOR: JOE JOHNSON
 PROPERTY LOCATED AT TUCKAHOE
 TOWN OF SOUTHAMPTON
 SUFFOLK COUNTY, NEW YORK
 S.C.T.M. # 900-129-02-2
 AREA = 24,346 SF = 0.5589 AC
 SCALE: 1"=40'

NOTE: THE EXISTENCE OF RIGHT OF WAYS,
 WETLANDS AND/OR EASEMENTS OF RECORD
 IF ANY, NOT SHOWN ARE NOT GUARANTEED.

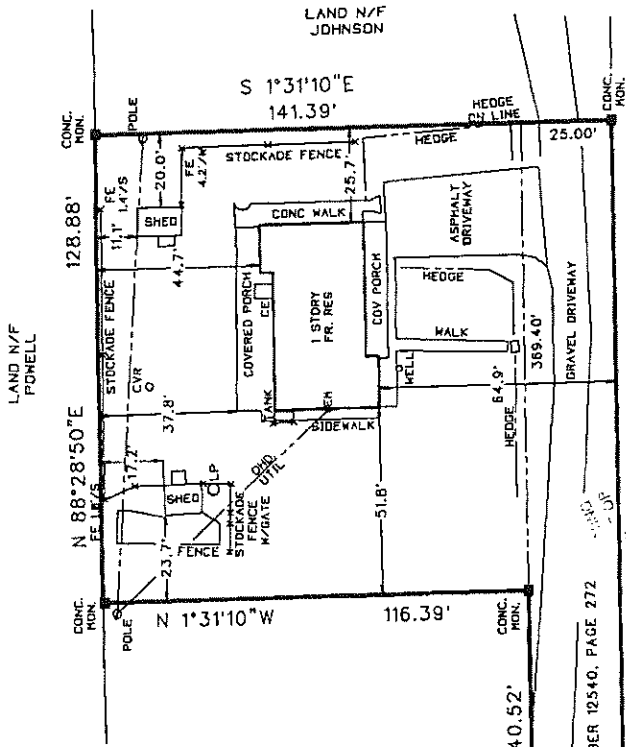

WHITES
 LANE

7

CERTIFIED TO:
 JOE JOHNSON

John Barylski

21899


UNAUTHORIZED ALTERATION OR ADDITION TO THIS SURVEY IS A VIOLATION
 OF SECTION 7208 OF THE NEW YORK STATE EDUCATION LAW.

COPIES OF THIS SURVEY MAY NOT BEARING THE LAND SURVEYORS INKED
 OR EMBOSSED SEAL SHALL NOT BE CONSIDERED TO BE A VALID TRUE COPY.
 GUARANTEES OR CERTIFICATIONS INDICATED HEREON SHALL RUN ONLY TO
 THE TITLE COMPANY, GOVERNMENTAL AGENCY AND/OR INDIVIDUALS
 LISTED HEREON, AND TO THE ASSIGNEES OF THE LISTING INSTITUTION.
 GUARANTEES OR CERTIFICATIONS ARE NOT TRANSFERABLE TO ADDITIONAL
 INSTITUTIONS OR SUBSEQUENT OWNERS.

LAND N/F
 S & K
 BARYLSKI

LAND N/F
 GHOLSON

Permit approval is conditional
 subject to field inspection

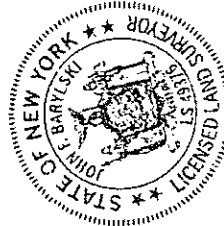

SURVEYED BY:
 BARYLSKI LAND SURVEYING
 2320 MAIN ST. P.O. BOX 1302
 NEWMAN VILLAGE CONDO.
 BRIDGEHAMPTON, NEW YORK
 (631-537-7944)
 MARCH 18, 2016