



TESTHOLE
12-22-88

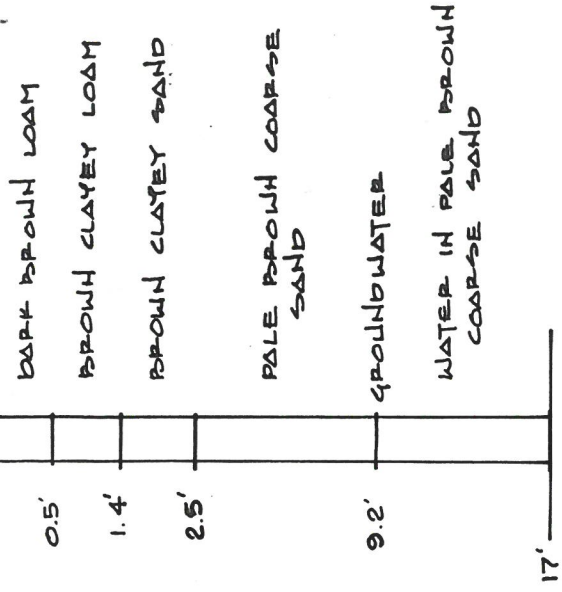

MAIN STREET
(SOUTH COUNTRY ROAD)

House Well

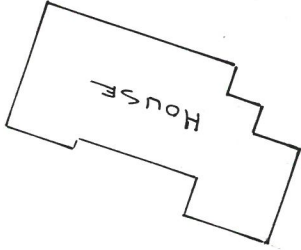

PETER KERN
(HOUSE, WELL AND SEPTIC)

SEPTIC PUMP
HOUSE, WELL
& SEPTIC
OWNER

100' RADIUS
100.00' RADIUS
100.00' RADIUS

DRIVE

CLUB

1-5-89
PROPOSED
HOUSE

TESTHOLE

PROP. SEPTIC

14' 00" W

VACANT

JUNE CROSS & JENNIE PASKIEWICZ

(284.32 TO CLOSE)

ELEVATIONS TAKEN FROM FIVE EASTERN
TOWNS TOPOGRAPHIC MAP.

NOTE:

SUBDIVISION ENTITLED BAY BREEZE
Lot 13
Mankly & WILLIAM BAKER
HOUSE, WELL & SEPTIC
(RENTER HAD NO IDEA AS TO LOCATION)

P-40 ZONING

MAP OF PROPERTY

BLAISE & KATHERINE FERRANDINO
SITUATE

REMSENBERG

TOWN OF SOUTHAMPTON — SUFFOLK COUNTY, N.Y.

SURVEYED: — SCALE: 1" INCH = 40' FEET
MAP PREPARED FROM DEED: DEC 24, 1988

TAX MAP

DISTRICT 0900
SECTION 380
POLOCK 02
LOT 57.1

UNAUTHORIZED ALTERATION OR ADDITION
TO THIS SURVEY IS A VIOLATION OF
SECTION 7209 OF THE NEW YORK STATE
EDUCATION LAW.
COPIES OF THIS SURVEY MAP NOT BEARING
THE LAND SURVEYOR'S INKED SEAL OR
EMBOSSED SEAL SHALL NOT BE CONSIDERED
TO BE A VALID TRUE COPY.
GUARANTEES INDICATED HEREON SHALL RUN
ONLY TO THE PERSON FOR WHOM THE SURVEY
IS PREPARED, AND ON HIS BEHALF TO THE
TITLE COMPANY, GOVERNMENTAL AGENCY AND
LENDING INSTITUTION LISTED HEREON, AND
TO THE ASSIGNEES OF THE LENDING INSTI-
TUTION. GUARANTEES ARE NOT TRANSFERABLE
TO ADDITIONAL INSTITUTIONS OR SUBSEQUENT
OWNERS.

D27-D-21

RAYNOR & MARCKS
SURVEYORS, P.C.
QUOGUE, N.Y.
516-653-4066

■ = CONCRETE MONUMENT
△ = WOOD STAKE
BK. PG.
AREA = 28,622 SQ. FT.

CERTIFIED TO:

