


BLUE MARLIN DRIVE

Land of Reese
"Proposed canal"

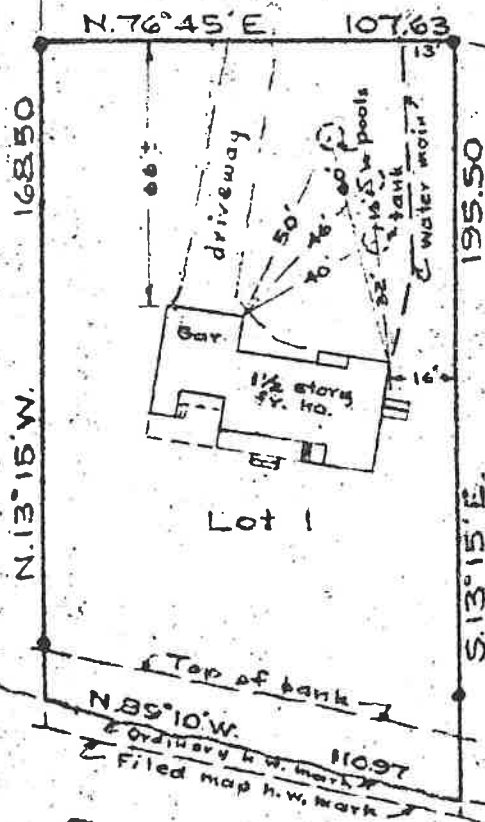

PECONIC BAY

MAP OF LAND
SURVEYED FOR
CLIFFORD & EUNICE BENFIELD
AT
"ARSHAMOMOQUE"
TOWN OF SOUTHOLD, N.Y.

Scale: 50' = 1"

• = iron pipe

Title No. 78-52-19931

Tax Parcel: 1000-56-7-19

Guaranteed to
Chemical Bank of New York and
U. S. Life Title Insurance Co.
as surveyed May 1, 1978.

Roderick Van Tuyl, P. C.

R. Van Tuyl
Licensed Land Surveyors
Greenport, New York

REPRODUCED ALTERATION OR ADDITION
TO THIS SURVEY IS A VIOLATION OF
SECTION 7209 OF THE NEW YORK STATE
EDUCATION LAW.

COPIES OF THIS SURVEY MAP NOT BEARING
THE LAND SURVEYOR'S INKED SEAL OR
EMBOSSED SEAL SHALL NOT BE CONSIDERED
TO BE A VALID TRUE COPY.

GUARANTEES INDICATED HEREON SHALL RUN
ONLY TO THE PERSON FOR WHOM THE SURVEY
IS PREPARED, AND ON HIS BEHALF TO THE
TITLE COMPANY, GOVERNMENTAL AGENCY AND
LENDING INSTITUTION LISTED HEREON, AND
TO THE ASSIGNEES OF THE LENDING INSTI-
TUTION. GUARANTEES ARE NOT TRANSFERABLE
TO ADDITIONAL INSTITUTIONS OR SUBSEQUENT
OWNERS.

Note: Lot numbers shown refer to
"Map of Southold Shores", filed in
the Suffolk County Clerk's office
on May 11, 1977